


Section 15 Township 21 Range 13-W

Well No. #1 Hall

Company Skelly
Rothgarn Pool

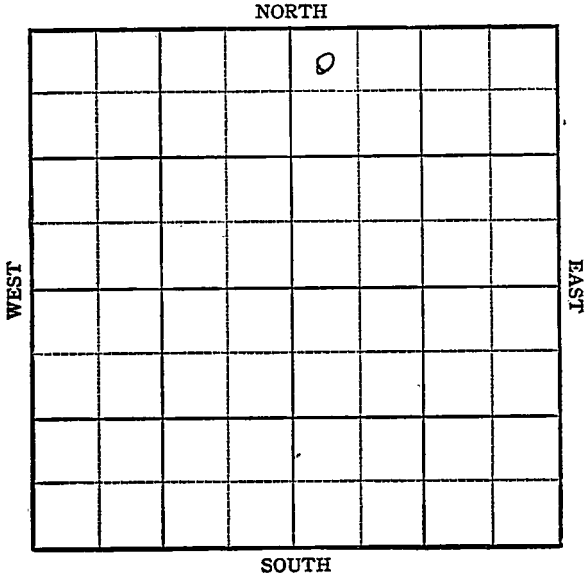

KANSAS

Stafford

Sec. 15 Twp. 21 R. 13W

Well No. #1 Hall Farm

Skelly

Company

Rothgarn Pool

NORTH


330' Ft. from N. Line

Ft. from S. Line

Ft. from E. Line

330' Ft. from W. Line

WEST

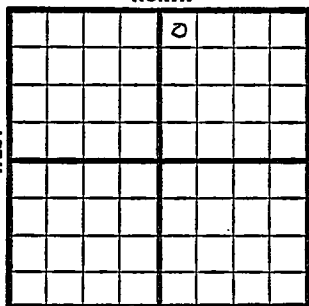

EAST

SOUTH

NW NE

1948

Elev 1880' REPORT

12/1 Location
12/6 8" @ 755'
12/14 2600 fsg.
12/22 Lansing 3289'
Arbuckle 3557'
TD 3560'
Run 5"
12/29 5" @ 3557'
1/5 500 acid
TD 3568'
750 acid
Pump 151 bbl oil 12 hrs
1/12 "
1/19 "
1/26 Pump 108 oil in 8 hrs.
2/2 TD 3568'
Arb. 3560'
5"@ 3560'
750 acid
Pump 120 oil Pot
39° Gr.,
Comp

COMPLETED

Map No. _____ Sec. 15 Twp. 21 R. 13W

Well No. 1 Hall

Skelly Company

FIRST REPORT

Contractor

NW NE


SECTION PLAT

330 Ft. from N. Line

_____ Ft. from S. Line

_____ Ft. from E. Line

330 Ft. from W. Line

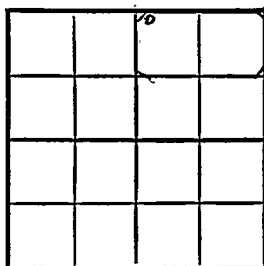

Stafford County

Location X

Rig up _____

Drilling and Remarks:

RECORD

Cased _____ in., _____ ft.

Sand _____

Gas _____

Oil _____

Total Depth _____

PRODUCTION

1st 24 hrs. Nat. _____

1st 24 hrs. after shot _____

Gas _____ Cu. Ft.

Dry Hole _____

Abandoned _____

Date

DEC 1 1948

19

S. J. LEWIS

Scout

Scout Cards
Land Small Map
Land Wall Map
Tracings
France Map
Pierce Map
Misc.

Map No. 82 Sec. 15 Twp. 21 R. 13W

Well No. 1 Hall

Skelly Company

COMPLETE


Contractor

NW NE

E 11/1880

SECTION PLAT

330 Ft. from N. Line

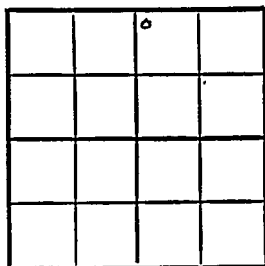

 Ft. from S. Line

 Ft. from E. Line

330 Ft. from W. Line

Stafford County

Location

Rig up

Drilling and Remarks:

*Cor 43560
5" @ 3560.
750 acid
Pump 120 oil
- 89° SW*

RECORD

Cased in., ft.

Sand

Gas

Oil

Total Depth 3565'

PRODUCTION

1st 24 hrs. Nat.

1st 24 hrs. after shot

Gas Cu. Ft.

Dry Hole

Abandoned

Date

FEB 2 1949

19

S. J. LEWIS

Scout

Scout Cards.....
Land Small Map.....
Land Wall Map.....
Tracings.....
France Map.....
Pierce Map.....
Misc.

Edith
all
PE