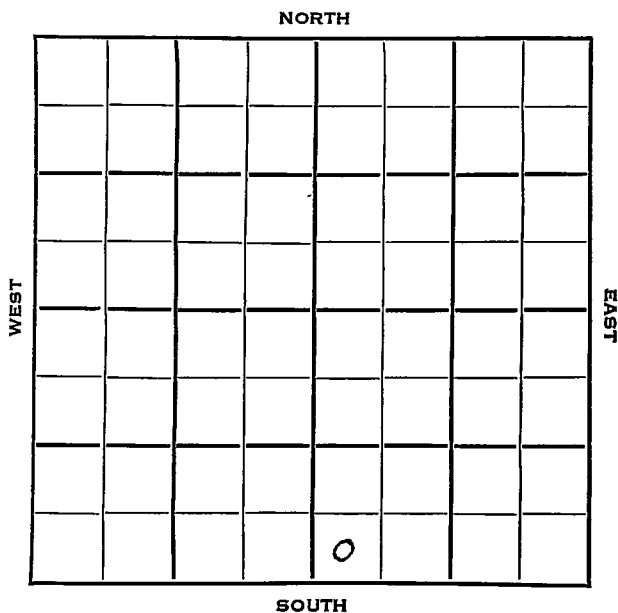


Section 15 Township 21 Range 11WWell No. #1 BatmanCompany CRA & Kaufman


Stafford

KANSAS ✓

Sec. 15 Twp. 21 R. 14WWell No. #1 Batman "B" FarmCRA & Kaufman CompanyCRA ContractorBayer Pool Ft. from N. Line330 Ft. from S. Line Ft. from E. Line330 Ft. from W. Line

SW SW SE

CSO & Conoco - DHM

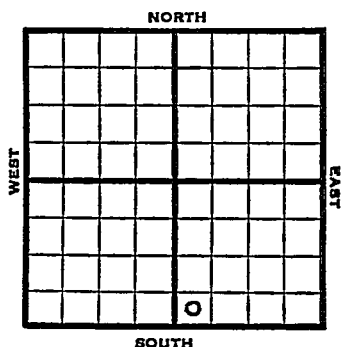

1953

Elev. 1934' REPORT


4/22 Cellar & Pits

4/30 8" @ 268

5/7 Drlg.

5/13 Spud 4-27-53 D & A TD 3771'
 8" @ 268 Heeb 3270' Tor 3296'
 Doug 3313 Br lime 3389 Lans 3401
 B KC 3631 Viola 3663 Simp sh. 3697
 Simp sd 3719' B. Simp. sd 3723'
 Arb. 3744' TD 3771'
 D & A

ABANDONED

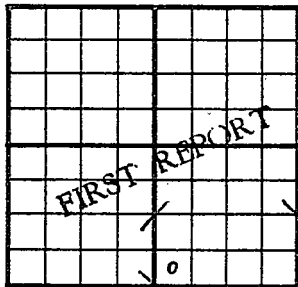County **Stafford** State **Kansas**Sec. **15** (Blk. **21** (Sur. **14W** Map No. (Twp. **Rge.**)Operator **CRA & Kaufman**Well No. **1** Farm **Batman**Elev. Location **SW SW SE****330** Ft. From **S** Line **SE****330** Ft. From **W** Line Quarter1st. Report **APR 22 1953**


Completion

Remarks **CSO & Conoco - DEM****CRA - Contr.**

Spudding Date

Drig. Data **Bayer Pool****Cellar & pits**

County Stafford State Kansas
 Sec. 15 (Blk. 21) (Sur. 14W) (Twp. Rge.) Map No.
 Operator C R A & Kaufman
 Well No. 1 Farm Batman "B"
 Elev. 1934 Location SW SW SE

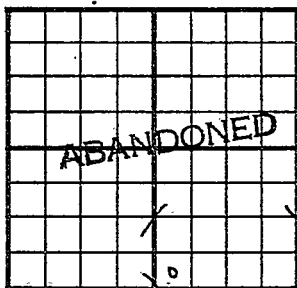

330 Ft. From S Line SE
330 Ft. From W Line Quarter
 Ist. Report
 Completion MAY 13 1953
 Remarks Bayer Pool
CRA - Contr.
 Spudding Date 4-27-53

Drlg. Data D & A TD 3771
8" @ 268 Heeb. 3270 Tor. 3296
Doug. 3313 Br. lime 3389 Lans. 3401
B KC 3631 Viola 3663 Simp. sh. 3697
Simp. sd. 3719 B. Simp. sd. 3723
Arb. 3744 TD 3771

D & A

J. G. McGEHEE