

Section 15 Township 21 Range 11WWell No. #1 T. TaylorCompany Stanolind

NORTH

|  |  |  |   |  |  |  |  |
|--|--|--|---|--|--|--|--|
|  |  |  | 0 |  |  |  |  |
|  |  |  |   |  |  |  |  |
|  |  |  |   |  |  |  |  |
WEST

EAST

SOUTH

Stafford

KANSAS

Sec. 15 Twp. 21 R. 14 W

Well No. # 1 T. Taylor Farm

Stanolind Company

Iron Drlg. Contractor

Wildcat


330 Ft. from N. Line

Ft. from S. Line

330 Ft. from E. Line

Ft. from W. Line

NE NE NW

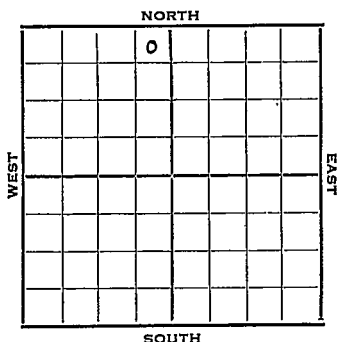

1951

Elev. 1928' REPORT

12/5

Spud 11-28-51  
Anhy 848'  
8" @ 855'  
Drlg. 2260'

1952  
1/16

Spud 11-28-51  
Oil well TD 3741' Anhy 848'  
8" @ 855' Heeb 3237' KC 3373'  
DST 3482-95 open 1 hr. rec 50' SW  
B KC 3584'  
DST 3569-87 open 1 hr. rec 15' mud  
DST 3585-3610 open 1 hr, rec 30' mud  
w/VSSO  
Simp. 3644'  
DST 3678-92 open 45 min. rec 600' oil  
Arb. 3703'  
DST 3702-08 open 1 hr. rec 50' OCM  
5" @ 3708 DD 3713' B/9 GWPH  
DD 3717' S/5 BWPH DD 3741'  
S/ 20 BWPH PB 3696' 36/3682-88  
S/3 BOPH Hydro. S/5 BOPH 8 hr.  
Comp. 104 BOPD

**COMPLETED**

County Stafford State KansasSec. 15 (Blk.) 21 (Sur.) 14W Map No.Operator StanolindWell No. 1 Farm T. TaylorElev. Location NE NE NW

|  |  |  |  |  |  |  |  |
|--|--|--|--|--|--|--|--|
|  |  |  |  |  |  |  |  |
|  |  |  |  |  |  |  |  |
**FIRST REPORT**

330 Ft. From N Line NW330 Ft. From E Line Quarter1st. Report DEC 5 1951

Completion

Remarks

Iron Drlg. - Contr.Spudding Date 11-28-51Drlg. Data WildcatAnhy 848 8" @ 855 drlg. 2260

|            |           |                     |           |                |         |         |  |
|------------|-----------|---------------------|-----------|----------------|---------|---------|--|
| County     | Stafford  |                     |           |                | State   | Kansas  |  |
| Sec.       | 15        | (Blk.<br>Twp.)      | 21        | (Sur.<br>Rge.) | 14W     | Map No. |  |
| Operator   | Stanolind |                     |           |                |         |         |  |
| Well No.   | 1         | Farm                | T. Taylor |                |         |         |  |
| Elev.      | 1928      | Location            | NE NE NW  |                |         |         |  |
|            |           | 330 Ft. From        |           | N Line         | NW      |         |  |
|            |           | 330 Ft. From        |           | E Line         | Quarter |         |  |
|            |           | 1st. Report         |           |                |         |         |  |
|            |           | Completion          |           | JAN 16 1952    |         |         |  |
|            |           | Remarks             |           | Wildcat        |         |         |  |
|            |           | Iron Drlg. - Contr. |           |                |         |         |  |
|            |           | Spudding Date       |           | 11-28-51       |         |         |  |
| Drlg. Data | Oil well  |                     | TD 3741   |                |         |         |  |

Anhy 848 8" @ 855 Heeb. 3237

KC 3373 DST 3482-95 open 1 hr.

Rec. 50' sw B KC 3584 DST 3569-87

open 1 hr. Rec. 15' mud DST 3585-3610

open 1 hr. Rec. 30' mud w/ vsso

Simp. 3644 DST 3678-92 open 45 min.

Rec. 600' oil Arb. 3703 DST 3702-08

open 1 hr. Rec. 50' ocm 5" @ 3708

DD 3713 B/ 9 gwph DD 3717

S/ 5 bwph DD 3741 S/ 20 bwph

PB 3696 36/ 3682-88 S/ 3 boph

Hydro. S/ 5 boph 8 hr.

Comp. 104 bopd

J. E. TYRA