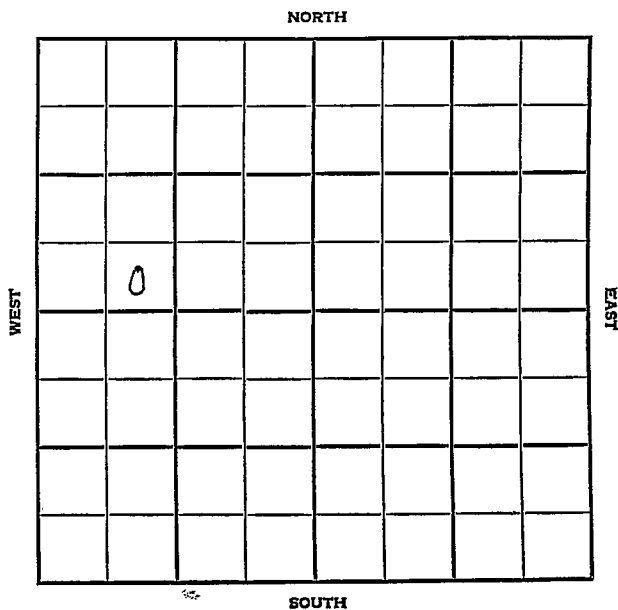


Section 15 Township 21 Range 14 WWell No. #1 TaylorCompany Eldorado Ref.

LOT FILE		Stafford	KANSAS
SEC. 4	11	11	R.
15	21	14 W	

WELL NO. # 1 Taylor FARM

COMPANY Eldorado Ref.

CONTRACTOR Sterling Taylor

SE SW NW

1/2 Mile - SDX Lse

	ELEVATION	REPORT
1955	1933'	

8/24 Comm. 8-18-55
8" @ 260/200
Drlg. 2200'
Anhy 870'

9-2 Heeb. 3259, Tor. 3283, Doug. 3300,
Br.lime 3376, Lans. 3386, Cong. 3637,
Viola 3642, Simp. 3691, ~~Lans. 3386~~
~~Cong. 3637~~, Arb. 3741,
T.D. 3755,
DST 3503-55, open $\frac{1}{2}$ hr. rec. 45' mud,
DST 3636-57, open $\frac{1}{2}$ hr., rec 5' mud, 0#
DST 3667-3718, open 1 hr., rec. 960'
fluid, 970/20",

9-8 TD 3755,
5 $\frac{1}{2}$ " @ 3755,
CO to 3730, 33/ 3711-15, FU 500' oil
20 min., 1000' oil in 2 hr., S/37.54
bo in 5 hr. FU 725' oil 24 hr.,
725' oil end of 40 hr., waiting on
orders

9-15 FU 969' oil in 64 hr., S/ 1.66 boph for
18 hrs., 500 A, frac S/ 11.7 bo in 12hr

9-22 No report

9-29 Pmp 25 bo plus 4% wtr. 24 hrs.

OX-78 OVER

1955

10/5

Comm 8-18-55
8" @ 260/200

Anh	870	
H	3259-	3261
Tr	3283	3289
Dg	3300	
Bl	3376	3379
L	3386	3390
BKC		3625
C	3637	3637
V	3642	3645
S	3691	3695
A	3741	3743
TD	3755	

DST 3503-55 open 1/2 hr Rec 45' mud

DST 3636-57 open 1/2 hr Rec 5' mud

O# DST 3667-3718 open 1 hr Rec 960'

fluid 970/20" TD 3755 5 1/2" @

3755/100 CO to 3730 33/3711-15

FU 500' oil 20 min FU 1000' oil 2 hr

S/37.54 bo 5 hr FU 725 ~~mx~~ oil 24 hr

969' oil 64 hr S/1.66 boph 18 hr

500 A frac S/11.7 B0 12 hr P/25 B0

4% wtr. Comp 32 bopd 3% wtr.

COMPLETED

County Starbford Elev. _____
 Sec. 25 Twp. 21 Rge. 11W
 Company El Dorado Ref.
 Farm Name Taylor No. 1

TOPS	DEPTH	LOG	DATUM	Loc. in Sec.
Anh.	870			SE SW 1/4
Tr.				
H.				
Dg.				
BL.				
L.				
K.C.				Geol.
B.K.C.				Contr.
Ce.				Sterling
C.				Pool
M.				Taylor
Mz.				
Ma.				
V.				
S.				
S.				
A.				
R.				
PE.				
G.				
TD.				

1/2 mile
 24 55
 0
 FIRST REPORT

Date Comm. 8-18-55
8" @ 260/200 drlg. 2200

[Handwritten signature]

Scout Cards	mm
Land Snail Map	
Land Well Map	
Tracings	
France Map	
Pierce Map	
Misc.	

AUG 29 1955

County Stafford Elev. 1933
 Sec. 15 Twp. 21 Rge. 11W
 Company El Dorado Ref.
 Farm Name Taylor No. 1

TOPS	DEPTH	LOG	DATUM	Loc. in Sec.
Anh.	870			SE SW NW
Tr.				
H.	3259	3261	1328	
Tr.	3283	3289	1356	
Dg.	3300			
Bl.	3376	3379	1446	
L.	3386	3390	1457	Geol.
K.C.				
B.K.C.		3625	1692	Contr.
Ce.				
C.	3637	3637	1704	Sterling
M.				
M.				Pool
K.				
Mz.				Taylor
Mq.				
V.	3642	3645	1712	
S.	3691	3695	1762	
S.				
A.	3741	3743	1810	
R.				
P.E.				
G.				
T.D.	3755			

COMPLETE

Date Comm. 8-18-55 OCT 5 1955

8" @ 260/200 DST 3503-55 open $\frac{1}{2}$ hr.

Rec. 45' mud DST 3636-57 open $\frac{1}{2}$ hr.

Rec. 5' mud ... 0# ... DST 3667-3718

open 1 hr. Rec. 960' fluid ... 970/20"

TD 3755 5 $\frac{1}{2}$ " @ 3755/100 CO to 3730

33/ 3711-15 FU 500' oil 20 min.

FU 1000' oil 2 hr. S/ 37.54 bo 5 hr.

FU 725' oil 24 hr. 969' oil 64 hr.

OVER

OCT 14 1955

Scout Cards	<u>mm</u>
Land Small Map	<u> </u>
Land Wall Map	<u> </u>
Tracings	<u> </u>
France Map	<u> </u>
Pierce Map	<u> </u>
Misc.	<u> </u>

S/ 1.66 boph 18 hr. 500 A frac
S/ 11.7 bo 12 hr. P/ 25 bo 1/4 wtr.
Comp. 32. boph 3% wtr.