

KANSAS


Form 51-5M-4-36-Palace

Rice

Section 15 Township 21 Range 7-W

Well Number 1-Hauschild

Company S. & S. Dlg.

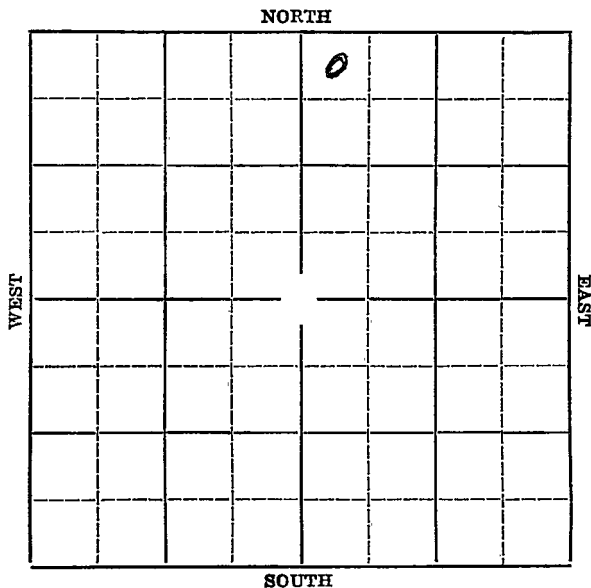

Map No. **KANSAS** Sec. **15** Twp. **21** R. **7-W**

Well No. **1 Hauschild** Farm

S. & S. Dlg. Company


330 Ft. from N. Line

Ft. from S. Line

Ft. from E. Line

330 Ft. from W. Line

Elev: 1604

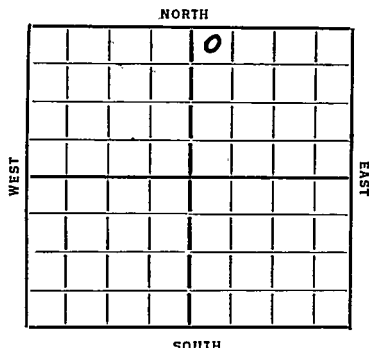

Date	REPORT
1936	
4/22	Location
4/30	Rig. & S.D.
5/7	--
5/14	Drlg. 186'.
5/21	Drlg. 2866'.
5/28	Chat 3370'. 6" @ 3368'. T.D. 3379'. Waiting on cement.
6/4	Top Chat 3370 Total Depth 3379 Flowed 451 bbls. per hour for 5 hours Lots of gas (Tel)
6/10/36	-Chat 3370'. T.D. 3379'. Est. 10,040 bbls oil.
	COMPLETED

KANSAS

Map No. 49 Sec. 15 Twp. 21 R. 7XXWell No. 1 HauschildS. & S. Drilling CompanyJ Contractor

SECTION PLAT

330 Ft. from N. Line

..... Ft. from S. Line

..... Ft. from E. Line

330 Ft. from W. Line

		o	

FIRST REPORT

Location ✓

Rig up

Drilling and Remarks:

RECORD

Cased in., ft.

Sand

Gas

Oil

Total Depth

PRODUCTION

1st 24 hrs. Nat.

1st 24 hrs. after shot

Gas Cu. Ft.

Dry Hole

Abandoned

Date

APR 22 1930

192

S. J. LEWIS

Scout

Map No. 49 KANSAS Sec. 15 Twp. 21 R. 7 NWell No. 1 HauschildB & S Drilling Company

Contractor

SECTION PLAT

		0	

330 Ft. from N. Line

_____ Ft. from S. Line

_____ Ft. from E. Line

330 Ft. from W. Line

COMPLETED

Location _____

Rig up _____

Drilling and Remarks:

Cha Y 3370E & Y. 70,040 88 1/2

RECORD

Cased _____ in., _____ ft.

Sand _____

Gas _____

Oil _____

Total Depth 3329

PRODUCTION

1st 24 hrs. Nat. _____

1st 24 hrs. after shot _____

Gas _____ Cu. Ft.

Dry Hole _____

Abandoned _____

Date

JUN 10 1936

19

J. LEWIS

Scout