


Section 15 Township 21 Range 7-W

Well No. ~~#6~~ Hauschild #5

Company Bridgeport Machine

NORTH Houschild Pool

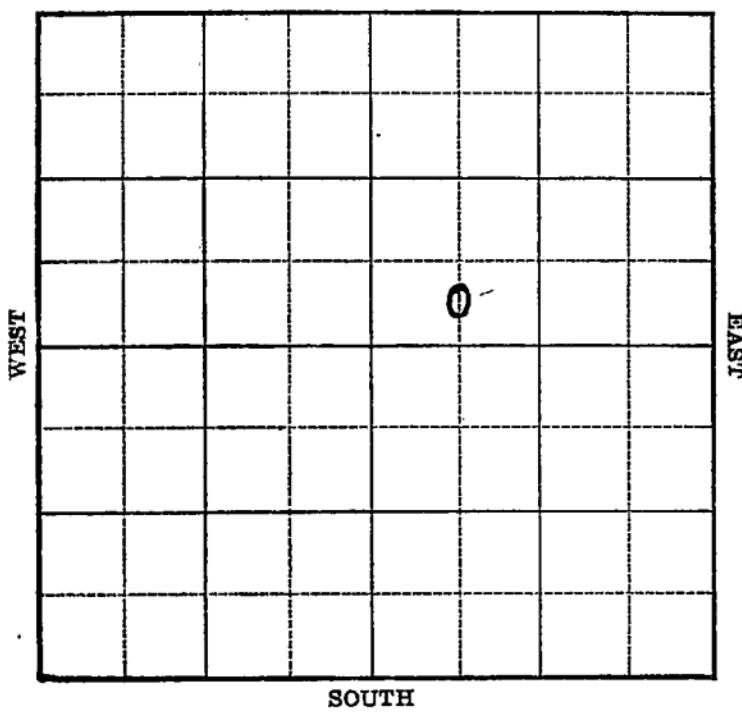


Sec. 15 Twp. 21 R. 7-WWell No. #5 Hauschild #5 Farm

Bridgeport Machine

Company

(Hauschild)

Ft. from N. Line

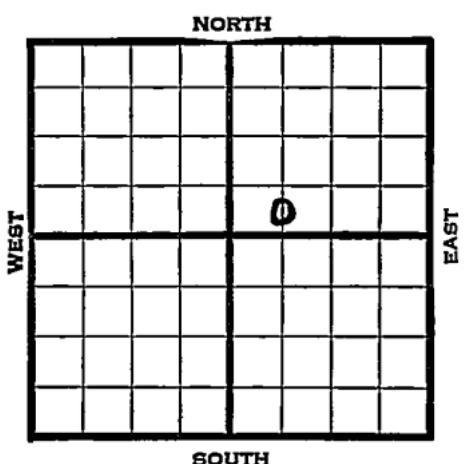330 Ft. from S. Line

Ft. from E. Line

660 Ft. from W. Line

Elev. 1604

1939	REPORT
8/2	Location
8/10	12" - 110' WOC.
8/17	Drlg. 2625'
8/24	Cong. 3379' Run 7"
8/31	7" - 3379' T.D. 3393' 900' oil 8 hours. Shut down.
9/7	" " " " "
9/14	" " " " "
9/21	" " " " "
9/28	" " " " "
10/4	Cong. 3379' 7" - 3379' T.D. 3393' 40 bbls. oil.
	COMPLETED

Rice

KANSAS

Map No. _____ Sec. 15 Twp. 21 R. 7W

Well No. 6 Hauschild

Bridgeport Machine Company

Contractor

FIRST REPORT

SECTION PLAT


C S L SW NE

Ft. from N. Line

330 Ft. from S. Line

Ft. from E. Line

660 Ft. from W. Line

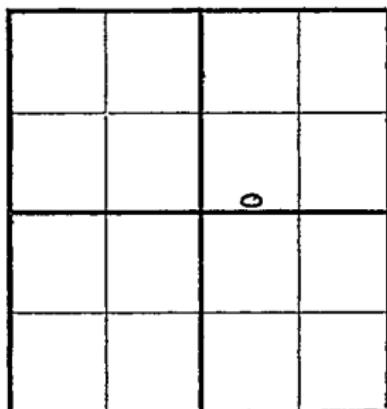

HAUSCHILD POOL

Location

RECORD

Cased in., ft.

Sand _____

Gas _____

Oil _____

Total Depth _____

PRODUCTION

1st 24 hrs. Nat. _____

1st 24 hrs. after shot _____

Gas Cu. Ft. _____

Dry Hole _____

Abandoned _____

Date

AUG 2 1939 19

S. J. LEWIS

Scout

Rice

KANSAS

Map No. 49 Sec. 15 Twp. 21 R. 7WWell No. 5 Hauschild

Bridgeport Machine

Company

CORRECTION

Contractor

SECTION PLAT

C S L SW NE


____ Ft. from N. Line

330 Ft. from S. Line

____ Ft. from E. Line

660 Ft. from W. Line

HAUSCHILD POOL

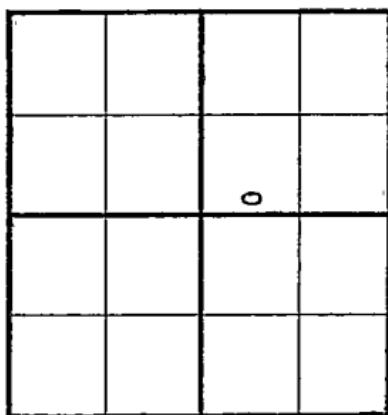

Location _____

RECORD

Cased _____ in., _____ ft.

Rig up _____

Sand _____

Drilling and Remarks:

Gas _____

Reported:

Oil _____

as #6

Total Depth _____

PRODUCTION

1st 24 hrs. Nat. _____

1st 24 hrs. after shot _____

Gas _____ Cu. Ft.

Dry Hole _____

Abandoned _____

Date

AUG 16 1939

19

S. J. LEWIS Scout

Rice

Map No. 49 Sec. 15 Twp. 21 R. 7WWell No. 5 Hauschild


Bridgeport Machine Company

Contractor

COMPLETED

C S L SW NE

SECTION PLAT

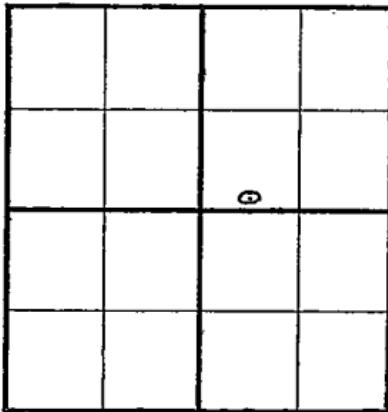

Ft. from N. Line

330 Ft. from S. Line

Ft. from E. Line

660 Ft. from W. Line

HAUSCHILD POOL

Location _____

RECORD

Cased _____ in., _____ ft.

Sand _____

Gas _____

Oil _____

Total Depth 339 3

PRODUCTION

1st 24 hrs. Nat. _____

1st 24 hrs. after shot _____

Gas _____ Cu. Ft.

Dry Hole _____

Abandoned _____

Date

OCT 4 1939
19

S. J. LEWIS Scout