


Section 15 Township 21 Range 12 W

Well No. # 1 Christiansen

Company Anschutz Drlg.

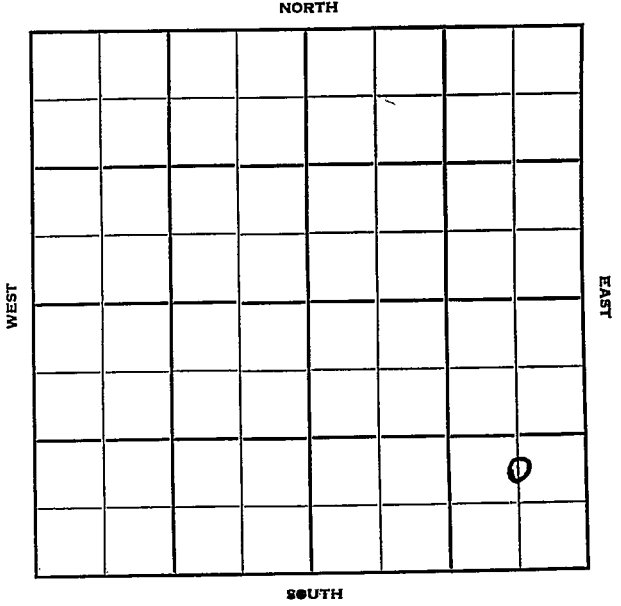

Sec. 15 Twp. 21 R. 12 W

Well No. # 1 Christiansen Farm

Anschutz Drlg. Company

Anschutz Contractor


_____ Ft. from N. Line

990 Ft. from S. Line

660 Ft. from E. Line

_____ Ft. from W. Line

C N L SE SE

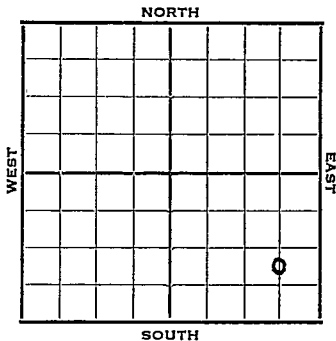

1952	Elev. 1840	REPORT
7/9	RUR	
7/17	8" @ 315'	Anhy 670' Topeka 2555' Drlg. 3095'
7/23	Heeb. 3085 Lans. 3240	Br Li 3225
	DST 3270-77, 3/4 hrs. gas in 18"	
	90' Hvy GCM & W 550#	
	DST 3359-65, 1 hr. gas in 25"	
	275' clean oil 1110#	
	V 3479	Simp. 3494
	DST 3478-96 1 hr. 20' VSQ&GCM	Off
	Arb. 3543	TD 3550'
	5" @ 3546'	WOCT
7/30	DD 3358'	500 A S/ 1 1/2 Boph DD 3561 1500 A S/ 1/2 Boph DD 3569 1000 A
8/6	S/3 1/2 BOPH for 4 hrs	DD 3616 TD S/4 Bfph 30% wtr PB 3605 1000 A S/3 1/4 BOPH PB 3425 32/3362-70 500 A S/41 BO 1st hr S/35 BO 2nd hr.
8/13	NR	
8/20	P/132 BO & 8 1/2 BW	14 hrs.
8/27	NR	
9/3	P/152 BO & 15 BW	18 hrs.
9/10	NR	
9/17	"	

OVER

1952

9/24

Spud 7-8-52 Oil Well TD 3616
8" @ 315 Anhy 670 Top. 2555
Heeb. 3085 Br Lime 3225
Lans. 3240

DST 3270-77 opn 3/4 hr. gas in 18
min. Rec. 90' hgcm & w 550#

DST 3359-85 opn 1 hr. gas in 23 min.
Rec. 275' clean oil 1110#

Viola 3479 Simp 3494

DST 3478-96 opn 1 hr. Rec.

20' vso & gcm O# Arb. 3543

TD 3550 5" @ 3546 DD 3558

500 A S/1 1/2 boph DD 3563

1500 A S/1/2 boph DD 3571

1000 A S/3 1/2 boph DD 3616

S/4 bfph 30% wtr. PB 3605

1000A S/3 1/2 boph PB 3425

32/3362-70 500 A S/41 bo 1hr.

S/35 bo 2nd hr. P/132 bo 8 1/2 bw 14 hr

P/152 BO 15 bw 18hrs.

Comp. 287 bopd

COMPLETED

JUL 11 1952

Scout Cards
Land Small Map
Land Wall Map
Tracings
France Map
Pierce Map
Misc.

Drig. Data

Scout Cards _____
 Land Small Map _____
 Land Wall Map _____
 Tracings _____
 France Map _____
 Pierce Map _____
 Misc. _____

Handwritten scribbles and marks

Comp. 287 bopd

P/ 152 bo 15 bw 18 hr.

Drig. Data