

KANSAS

Stafford

Section 15 Township 21 Range 12W

Well No. 1 Christansen "A"

Company Virginia Drlg.

Sittner

NORTH

							o

WEST

EAST

SOUTH

O.W.W.O.

KANSAS

Stafford


Sec. 15 Twp. 21 R. 12W

Well No. #1 Christansen "A" Farm

Virginia Drlg. Company

Sittner Pool

_____ Ft. from N. Line
330'
 _____ Ft. from S. Line
330'
 _____ Ft. from E. Line
 _____ Ft. from W. Line

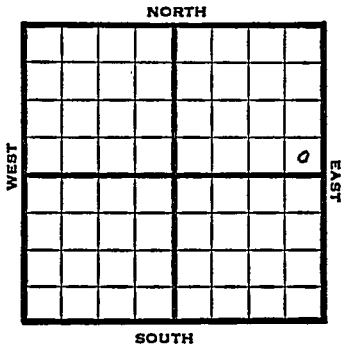

SE NE

1949 Elev 1839' REPORT

5/4 8" @ 215'
 5/10 SD for titles
 5/18 "
 5/25 "
 6/1 "
 6/7 "
 6/15 Arbuckle 3561'
 TD 3569'
 6/21 5" @ 3561'
 6/28 "
 7/6 "
 7/12 TD 3587'
 10 qts 3577-87 - 500 acid
 7/20 "
 7/27 Drlg 3651&
 8/3 TD 3700'
 Arb. 3561'
 Aba_nd.
 1950 **ABANDONED** O.W.W.O.
 9/20 Simp 3518 Arb 3561
 5" @ 3561'
 OTD 3602 D&A
 CO to 3188 DD to 3350 w/iron in hole
 to whipstock & drill to Arb

OVER

1950

10/18 D&A TD 3400'
Simp. 3518'
Arb. 3561'
5" @ 3561' OTD 3602'
CO to 3188 DD to 3350
w/iron in hole to whipstock & drill
to Arb.
CO to 3290
PB 3074 TD 3400
5" @ 3398'
18/3357-63 B 3342 30/3224-32 SSO
500 A No inc. Perf 3279-86
D&A

ABANDONED

Kansas

Sittner Pool

Map No. K46 Sec. 15 Twp. 21 R. 12WWell No. 1 Christansen "A"

Virginia Drlg.

Company

ABANDONED

Contractor

SE NE

E. 11839
SECTION PLAT

			o

_____ Ft. from N. Line

330

_____ Ft. from S. Line

330

_____ Ft. from E. Line

_____ Ft. from W. Line

Stafford County

Location _____

Rig up _____

Drilling and Remarks:

CR 43561

RECORD

Cased _____ in., _____ ft.

Sand _____

Gas _____

Oil _____

Total Depth 9200

PRODUCTION

1st 24 hrs. Nat. _____

1st 24 hrs. after shot _____

Gas _____ Cu. Ft.

Dry Hole _____

Abandoned _____

Date

AUG 3 1949 19

S. J. LEWIS

Scout

