


Section 15 Township 21 Range 12-W

Well No. #1, Christiansen Heirs

Company Magnolia Petroleum Company

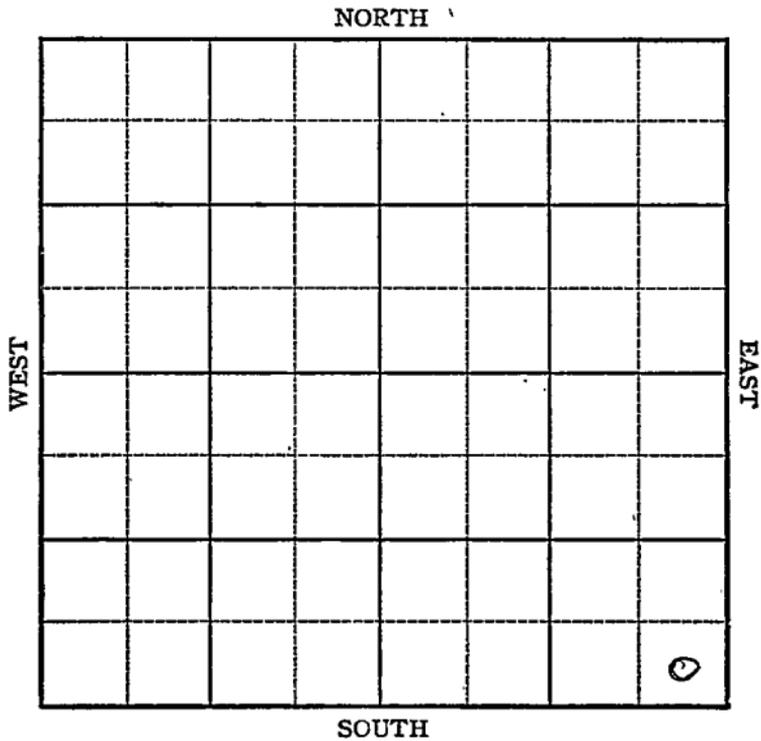

Sec. 15 Twp. 21 R. 12W

Well No. 1 Christiansen Heirs Farm

Magnolia

Company

Muellër Pool


Ft. from N. Line

330 Ft. from S. Line

330 Ft. from E. Line

Ft. from W. Line

NORTH

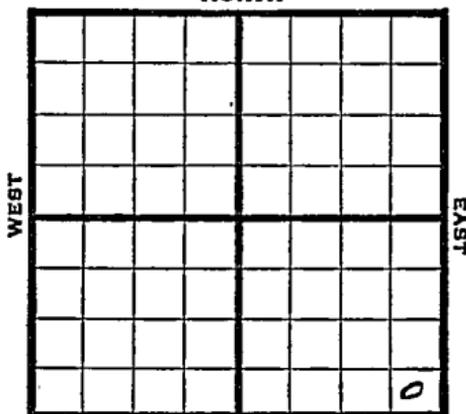

SOUTH

SE/C

REPORT

1946

Elev. 1839'

11/27

Location

12/3

Drlg 276'

12/10

8" @ 276'
Drlg 2385'

12/17

Lans 3225
Viola 3468'
Simp 3489
Arb 3538'
TD 3541'
5" @ 3539 RUST

1947

1/2

Arb 3538'
5" @ 3539'
TD 3543'
1000 Acid
Pump 413 POT
39 Grav.

COMPLETED

Map No. 46 Sec. 15 Twp. 21 R. 12W

Well No. 1 Christiansen Heirs

Magnolia Company

FIRST REPORT

Contractor

SE/C

SECTION PLAT

 Ft. from N. Line

330 Ft. from S. Line

330 Ft. from E. Line

 Ft. from W. Line

Stafford County

RECORD

Location X

Cased in., ft.

Rig up

Sand

Drilling and Remarks:

Gas

Oil

Total Depth

PRODUCTION

1st 24 hrs. Nat.

1st 24 hrs. after shot

Gas Cu. Ft.

Dry Hole

Abandoned

Date

NOV 27 1946 19

S. J. LEWIS Scout

Kansas

KANSAS

Mueller Pool

Map No.

46

Sec.

15

Twp.

21

R. 12W

Well No.

1 Christiansen Heirs

Magnolia

Company

COMPLETED

Contractor

SE/C

E/1889

SECTION PLAT

_____ Ft. from N. Line

330 Ft. from S. Line

330 Ft. from E. Line

_____ Ft. from W. Line

			o

Stafford County

Location _____

Rig up _____

Drilling and Remarks:

*Ar 3538**5" @ 3538**1000 acid**Pump 413 P&Y**39 2/3*

RECORD

Cased _____ in., _____ ft.

Sand _____

Gas _____

Oil _____

Total Depth *3543*

PRODUCTION

1st 24 hrs. Nat. _____

1st 24 hrs. after shot _____

Gas _____ Cu. Ft.

Dry Hole _____

Abandoned _____

Date

JAN 2 1947 19

S. I. LEWIS Scout