

KANSAS


Kearney

Form 51—5M—7-39—Palace

Section 15 Township 21 Range 38-W


Well No. #1 J. M. Judd ✓

Company Stanolind

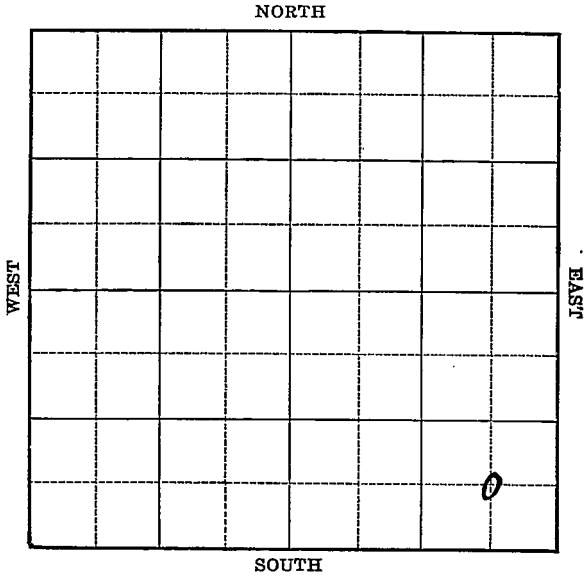

KANSAS

Kearney

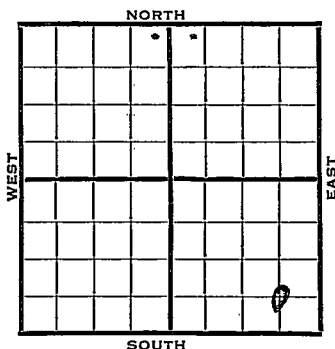Sec. 15 Twp. 21 R. 38-WWell No. #1 J. M. Judd FarmStanolind Company Ft. from N. Line660 Ft. from S. Line660 Ft. from E. Line Ft. from W. LineElev. 3347 Est DF
3344 Gr

	REPORT
1940	
4/10	Rotary location
4/18	" " "
4/25	" " "
5/2	" " "
5/9	Rigging up.
5/16	Spud 79'
5/23	157' WOC.
5/29	1085' run 10".
6/6	Drlg. 2580'
6/13	" "
6/20	Drlg. 3680'
6/27	4110' coring.
7/3	SD 4467' for repairs.
7/11	Drlg. 4643'
7/18	4870' SD repairs.
7/25	Drlg. 5113'
8/2	Drlg. 5385½'
8/8	Drlg. 5626'
8/14	Drlg. 6012'
8/22	Top. 3665' Lansing 4060'
	Miss. 4811' Viola 5425'
	OVER

1940
 8/29 Arb. 5555'
 Weathered Granite 6065'
 Granite 6070-71' T.D.
 P.B. to 5384' 7" - 4864' RUST.

 9/5 3785-88 $\frac{1}{2}$ SO & W.
 3768-72' SSO 3730-33 SO & W.
 3700-03 - 6 BW & SO.
 P.B. to 3700'

 9/12 " " "
 9/19 Drilled out to 3990'
 P.B. to 3860'

 9/26 T.D. 3859' 1000 acid.
 Swab 30 bbls. water, $\frac{1}{2}$ bbl. oil
 & 45 bbls. water & 1 bbl. oil.
 21.6 gravity. P.B. to 3737'

 10/3 " " " " "

 10/9 Granite 6070'
 T.D. 6071'
 No shows.

ABANDONED

Map No. NM Sec. 15 Twp. 21 R. 38WWell No. 1 J. M. JuddStanolind

Company

FIRST REPORT

Contractor

C SE SE

 Ft. from N. Line660 Ft. from S. Line660 Ft. from E. Line Ft. from W. Line**SECTION PLAT**

			o

Location XRig up

Drilling and Remarks:

Rotary**RECORD**Cased in., ft.Sand Gas Oil Total Depth **PRODUCTION**1st 24 hrs. Nat. 1st 24 hrs. after shot Gas Cu. Ft.Dry Hole Abandoned

Date

APR 10 1940 19S. J. LEWIS Scout

Map No. VM Sec. 15 Twp. 21 R. 38WWell No. 1 J. M. JuddStanolind Company

(Stratograph Hole) Contractor

ABANDONED

C SE SE

 Ft. from N. Line660 Ft. from S. Line660 Ft. from E. Line Ft. from W. Line

SECTION PLAT

			o

Location Rig up

Drilling and Remarks:

- Str. with 6070.No shows.

RECORD

Cased in., ft.Sand Gas Oil Total Depth 6071

PRODUCTION

1st 24 hrs. Nat. 1st 24 hrs. after shot Gas Cu. Ft.Dry Hole Abandoned

Date

OCT 9 1940 19 S. J. LEWIS Scout