


Give All Information Completely
Make Required Affidavit
Mail or Deliver Report to:
Conservation Division
State Corporation Commission
211 No. Broadway
Wichita, Kansas

WELL PLUGGING RECORD

Pawnee County, Sec. 12 Twp. 21 Rge. 16 ~~(E)~~ (W)
Location as "NE/CNW/SW" or footage from lines C NW NE NE
Lease Owner ANDERSON - PRICHARD
Lease Name Smith Well No. 2
Office Address Box 142 St. Bend
Character of Well (completed as Oil, Gas or Dry Hole) Oil
Date well completed Nov. 25 19 47
Application for plugging filed Feb. 15 19 57
Application for plugging approved Feb 16 19 57
Plugging commenced Feb 27 19 57
Plugging completed March 10 19 57
Reason for abandonment of well or producing formation Non-Commercial
If a producing well is abandoned, date of last production June 5 19 50
Was permission obtained from the Conservation Division or its agents before plugging was commenced? Yes

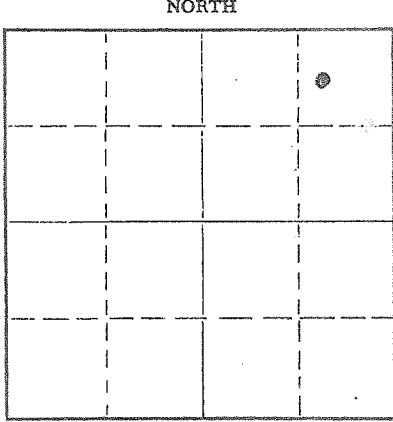

Locate well correctly on above Section Plat

Name of Conservation Agent who supervised plugging of this well C. D. Stough
Producing formation Arb. Depth to top 3761 Bottom Total Depth of Well 3783 Feet
Show depth and thickness of all water, oil and gas formations.

OIL, GAS OR WATER RECORDS

CASING RECORD

FORMATION	CONTENT	FROM	TO	SIZE	PUT IN	PULLED OUT
				8 3/8	950	0
				5 1/2"	3776	3008
					100 sacks cement	

Describe in detail the manner in which the well was plugged, indicating where the mud fluid was placed and the method or methods used in introducing it into the hole. If cement or other plugs were used, state the character of same and depth placed, from _____ feet to _____ feet for each plug set.

T. D. 3783
Plugged back to 3776' w/ crushed rock
Dumped 15 sacks cement w/ water to 3735'
Shot casing off at 3008'
Pulled casing
Filled hole with heavy mud to 300'
Set rock bridge & dumped 15' 15x cement @ 330'
Filled hole w/ heavy mud to 120'
Mixed 10 sacks cement for cap for well

(If additional description is necessary, use BACK of this sheet)
Name of Plugging Contractor Forbes Csg Drilling Co.
Address _____

STATE OF _____, COUNTY OF _____, ss.

(employee of owner) or (owner or operator) of the above-described well, being first duly sworn on oath, says: That I have knowledge of the facts, statements, and matters herein contained and the log of the above-described well as filed and that the same are true and correct. So help me God.

(Signature) _____

(Address) _____

SUBSCRIBED AND SWORN TO before me this _____ day of _____, 19 _____

My commission expires _____ Notary Public.

