


Give All Information Completely
Make Required Affidavit
Mail or Deliver Report to:
Conservation Division
State Corporation Commission
211 No. Broadway
Wichita, Kansas

WELL PLUGGING RECORD

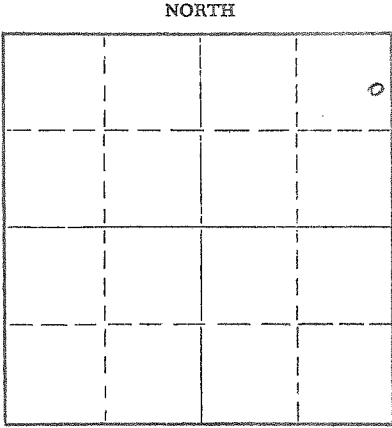

Locate well correctly on above Section Plat

Pawnee County, Sec. 12 Twp. 21 Rge. 16 (E) (W)
Location as "NE/CNW/SW" or footage from lines C. E. L. NE NE
Lease Owner Magnolia Pet. Co.
Lease Name Sara Smith Well No. 1
Office Address Box 885 Ellinwood, Kansas
Character of Well (completed as Oil, Gas or Dry Hole) Dry Hole
Date well completed June 14, 19 40
Application for plugging filed June 14, 19 40
Application for plugging approved June 14, 19 40
Plugging commenced June 14, 19 40
Plugging completed June 15, 19 40
Reason for abandonment of well or producing formation Dry Hole

If a producing well is abandoned, date of last production _____ 19 ____
Was permission obtained from the Conservation Division or its agents before plugging was commenced? Yes

Name of Conservation Agent who supervised plugging of this well C.T. Alexander
Producing formation none Depth to top _____ Bottom _____ Total Depth of Well 3787 Feet
Show depth and thickness of all water, oil and gas formations.

OIL, GAS OR WATER RECORDS

CASING RECORD

| FORMATION | CONTENT | FROM | TO | SIZE | PUT IN | PULLED OUT |
|--------------------------|----------------------|-------------|-------------|-----------------|------------|------------|
| <u>Kansas City Lime</u> | <u>dry</u> | <u>3406</u> | <u>3694</u> | <u>13" O.D.</u> | <u>115</u> | <u>0</u> |
| <u>Viola Lime</u> | <u>dry</u> | <u>3694</u> | <u>3722</u> | <u>9" O.D.</u> | <u>709</u> | <u>0</u> |
| <u>Simpson Formation</u> | <u>dry</u> | <u>3722</u> | <u>3764</u> | | | |
| <u>Arbuckle Lime</u> | <u>sulphur water</u> | <u>3764</u> | <u>3787</u> | | | |
| | | | | | | |
| | | | | | | |
| | | | | | | |

Describe in detail the manner in which the well was plugged, indicating where the mud fluid was placed and the method or methods used in introducing it into the hole. If cement or other plugs were used, state the character of same and depth placed, from _____ feet to _____ feet for each plug set.

Well plugged w/ 12 1/2" sx Incon by Halliburton thru drill pipe from 3387-3375
Filled w/ heavy drilling mud from 3375-740
" w/ 2 1/2" sx Incon by Halliburton thru drill pipe 740-660
" w/ heavy mud by " 660-16'
Bridged hole with 2' wood plug, from 16 to 14'
Filled w/ pack 9 8 sx cement from 14 to 8'
Welded steel cap over 13" x 9" Csg in bottom of cellar at 8 ft

(If additional description is necessary, use BACK of this sheet)

Name of Plugging Contractor _____
Address _____

STATE OF _____, COUNTY OF _____, ss. _____
(employee of owner) or (owner or operator) of the above-described well, being first duly sworn on oath, says: That I have knowledge of the facts, statements, and matters herein contained and the log of the above-described well as filed and that the same are true and correct. So help me God.

(Signature) _____

(Address) _____

SUBSCRIBED AND SWORN TO before me this _____ day of _____, 19 _____

My commission expires _____

Notary Public.

