


Give All Information Completely  
Make Required Affidavit  
Mail or Deliver Report to:  
Conservation Division  
State Corporation Commission  
211 No. Broadway  
Wichita, Kansas

WELL PLUGGING RECORD

Pawnee County, Sec. 12 Twp. 21 Rge. 16 ~~(E)~~ (W)

Location as "NE/CNW/SW" or footage from lines C E 1/2 NE-NE  
Lease Owner Anderson-Prichard Oil Corp.  
Lease Name Smith Well No. 1  
Office Address Box 142 Great Bend, Kans.  
Character of Well (completed as Oil, Gas or Dry Hole) Oil  
Date well completed Aug. 12, 1957  
Application for plugging filed Sept. 13, 1957  
Application for plugging approved Sept. 14, 1957  
Plugging commenced Sept. 14, 1957  
Plugging completed Sept. 22, 1957  
Reason for abandonment of well or producing formation Non-commercial

NORTH

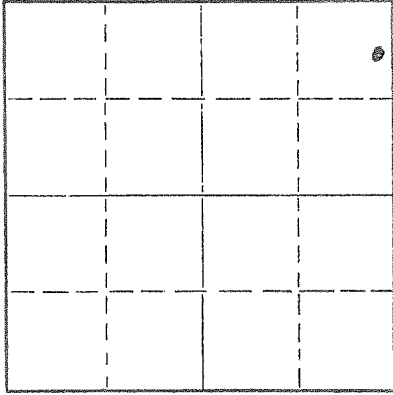

Locate well correctly on above  
Section Plat

If a producing well is abandoned, date of last production Aug. 10, 1957  
Was permission obtained from the Conservation Division or its agents before plugging was commenced? Yes

Name of Conservation Agent who supervised plugging of this well C. D. Stough  
Producing formation Ark Depth to top 3750 Bottom 3790 Total Depth of Well 3790 Feet  
Show depth and thickness of all water, oil and gas formations.

OIL, GAS OR WATER RECORDS

CASING RECORD

FORMATION	CONTENT	FROM	TO	SIZE	PUT IN	PULLED OUT
				13 3/8	115	0
				9"	709	0
				5 1/2"	3788	2055

Describe in detail the manner in which the well was plugged, indicating where the mud fluid was placed and the method or methods used in introducing it into the hole. If cement or other plugs were used, state the character of same and depth placed, from \_\_\_\_\_ feet to \_\_\_\_\_ feet for each plug set.

Plugged back from T.D. 3790 to 3737' w/ crushed rock & 30 sacks cement.  
Shot off csg 2055' Pulled Csg.  
Filled hole with mud to 700' of top  
Pumped in 250 sx cement to fill surface pipe  
Mixed 3 sx cement for cap on well

(If additional description is necessary, use BACK of this sheet)  
Name of Plugging Contractor Forbes Csg. Tapping Co  
Address \_\_\_\_\_

STATE OF \_\_\_\_\_, COUNTY OF \_\_\_\_\_, ss.  
\_\_\_\_\_(employee of owner) or (owner or operator) of the above-described well, being first duly sworn on oath, says: That I have knowledge of the facts, statements, and matters herein contained and the log of the above-described well as filed and that the same are true and correct. So help me God.

(Signature) \_\_\_\_\_

(Address) \_\_\_\_\_

SUBSCRIBED AND SWORN to before me this \_\_\_\_\_ day of \_\_\_\_\_, 19\_\_\_\_

My commission expires \_\_\_\_\_

Notary Public.



Surface pipe  $13\frac{5}{8}$  @ 116' Ann Cement.  $9\frac{5}{8}$  @ 709'  
Circ with cement.  $5\frac{1}{2}$ " csg @ 3790' w/ ~~150~~ 5x cement.  
Plugged back to 3780' w/ chat. Dumped 5 sacks  
cement @ 3780'. Filled hole with mud. Dumped  
in plug 4 250 ex cement filling hole from 600  
feet to the surface w/ cement Globe Oil Well  
Co. to. Forbes Csg Putting Co.