


Give All Information Completely  
Make Required Affidavit  
Mail or Deliver Report to:  
Conservation Division  
State Corporation Commission  
211 No. Broadway  
Wichita, Kansas

WELL PLUGGING RECORD

Pawnee County. Sec. 1 Twp. 21 Rge. 16 (~~E~~) (W)  
Location as "NE/CNW/SW" or footage from lines SE-SW-SE  
Lease Owner Rev F Brack Oil Co  
Lease Name Smith Well No. 2  
Office Address \_\_\_\_\_  
Character of Well (completed as Oil, Gas or Dry Hole) \_\_\_\_\_  
Date well completed Dec. 2 19 47  
Application for plugging filed Oct. 31 19 47  
Application for plugging approved Oct. 31 19 47  
Plugging commenced Oct. 31 19 47  
Plugging completed Nov. 2 19 47  
Reason for abandonment of well or producing formation DH & A

If a producing well is abandoned, date of last production June 6, 19 48  
Was permission obtained from the Conservation Division or its agents before plugging was commenced? Yes

Name of Conservation Agent who supervised plugging of this well C. D. Stough  
Producing formation Ark. Depth to top 3750 Bottom \_\_\_\_\_ Total Depth of Well 3775 Feet  
Show depth and thickness of all water, oil and gas formations.

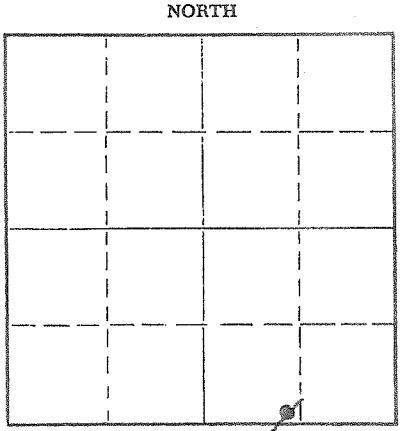

Locate well correctly on above Section Plat

OIL, GAS OR WATER RECORDS

CASING RECORD

| FORMATION                            | CONTENT | FROM        | TO          | SIZE         | PUT IN      | PULLED OUT  |
|--------------------------------------|---------|-------------|-------------|--------------|-------------|-------------|
| <u>Sand, surface soil &amp; clay</u> |         | <u>0</u>    | <u>940</u>  | <u>8 1/2</u> |             |             |
| <u>Ark.</u>                          |         | <u>3750</u> | <u>3775</u> | <u>5 1/2</u> | <u>3778</u> | <u>2198</u> |
|                                      |         |             |             |              |             |             |
|                                      |         |             |             |              |             |             |

Describe in detail the manner in which the well was plugged, indicating where the mud fluid was placed and the method or methods used in introducing it into the hole. If cement or other plugs were used, state the character of same and depth placed, from 250 feet to 30 feet for each plug set.

Plugged with chat to 3730' Dumped 5 sacks of cement worked casing loose at 2200' and mudded hole to 250' Set 10' rock bridge Dumped 15 sacks cement mudded up to 30' Dumped 10 sacks of cement on same

(If additional description is necessary, use BACK of this sheet)

Name of Plugging Contractor R. & L. Pipe Pulling Co.  
Address \_\_\_\_\_

STATE OF \_\_\_\_\_, COUNTY OF \_\_\_\_\_, ss. \_\_\_\_\_ (employee of owner) or (owner or operator) of the above-described well, being first duly sworn on oath, says: That I have knowledge of the facts, statements, and matters herein contained and the log of the above-described well as filed and that the same are true and correct. So help me God.

(Signature) \_\_\_\_\_

(Address) \_\_\_\_\_

SUBSCRIBED AND SWORN to before me this \_\_\_\_\_ day of \_\_\_\_\_, 19 \_\_\_\_\_

My commission expires \_\_\_\_\_ Notary Public.

Oscar W. Temp in charge  
J. Plugging for Brack

Surface pipe  $8\frac{5}{8}$ " at 940 feet. Cement circulate  
5/2" casing set at 3775'. Plugged back from  
bottom to 3740 ft. with chat. Dumped 5 sacks of  
cement in the 5/2 casing at 3740; shot off &  
pulled the 5/2 casing. Filled with mud to 250'  
Set rock bridge & 13 sacks of cement at 250 ft  
Mud to 30 ft. Bridge & 10 sacks of cement at the  
surface.