


Section 16 Township 21 Range 13 W

Well No. # 2 Grow

Company Western Rig

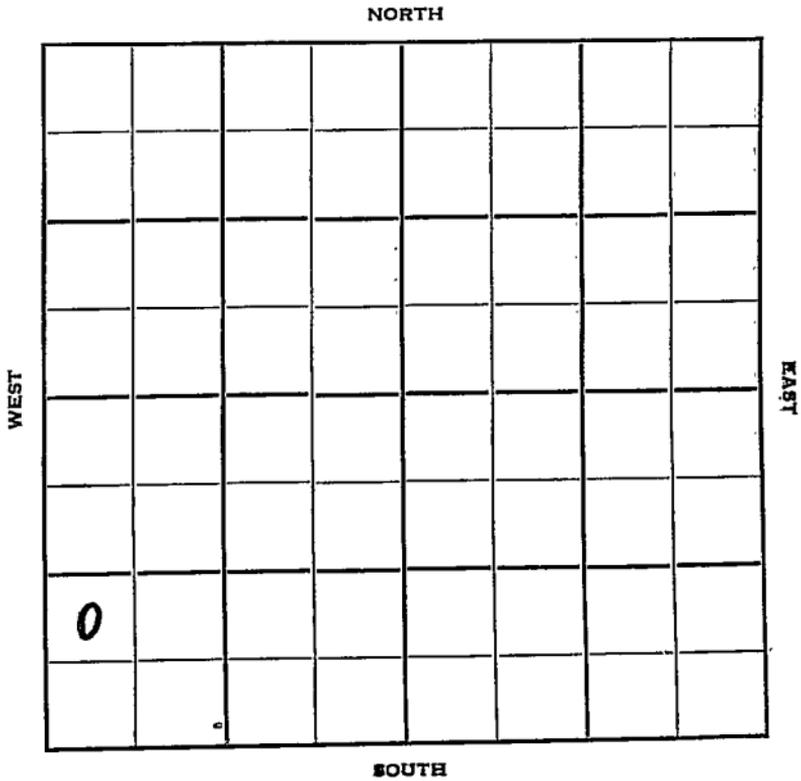

Sec. 16 Twp. 21 R. 13W

Well No. #2 Grow Farm \_\_\_\_\_

Western Rig Company \_\_\_\_\_

Peel Drlg. Contractor \_\_\_\_\_  
Hazel Pool

\_\_\_\_\_ Ft. from N. Line

990


\_\_\_\_\_ Ft. from S. Line

\_\_\_\_\_ Ft. from E. Line

330

\_\_\_\_\_ Ft. from W. Line

NW SW SW

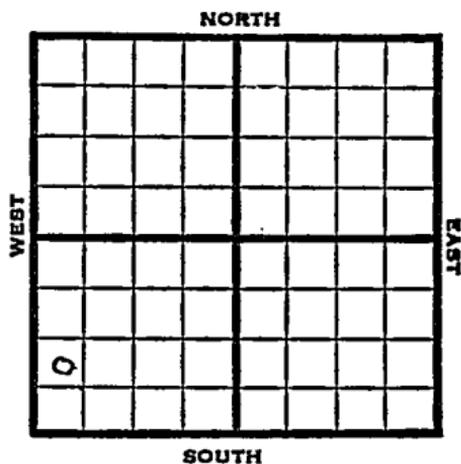

1952

Elev. 1899' REPORT

10/8

RUR

10/15

Drlg. 3015'

10/22

RTD 3669' 5" @ 3639 CO

10/29

Heeb 3215, Tor 3235, Douglas 3247,  
Br li 3338, Lans 3349, B KC 3555, Cong  
3614, Arb 3664  
TD 3700 Cor.  
5" @ 3669 $\frac{1}{2}$  CO

11/5

36/3665-76, 500A  
S/2 BOPH 1500A  
S/15 BOPH, POP

11/12

Spud 10-7-52  
Oil Well  
TD 3700  
8" @ 108  
Heeb 3215, Tor. 3235, Doug  
3247, Br. lime 3338, Lans 3349  
B KC 3555, Cong 3614, Arb 3664  
TD 3700  
5" @ 3669  
36/3665-76 500A  
S/2 boph 1500A S/15 boph  
Comp. 199 bopd

**COMPLETED**



