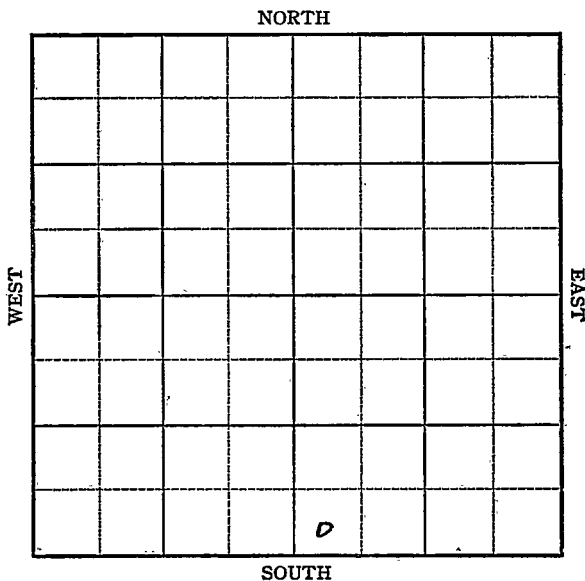


KANSAS

Stafford

Section 16 Township 21 Range 13WWell No. 1 GrowCompany Westgate-GreenlandWildcat

Sec. 16 Twp. 21 R. 13W ✓

Well No. #1 Grow Farm

Westgate-Greenland Company

Wildcat


 Ft. from N. Line

330'

 Ft. from S. Line

 Ft. from E. Line

330' Ft. from W. Line

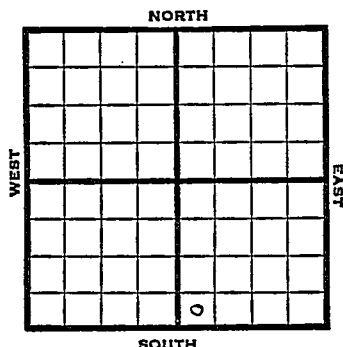

SW SE

1949

^E lev 1892' REPORT

5/25	Location
6/1	8" @ 292'
	Drlg 3069'
6/7	Lansing 3346'
	Arb. 3705-09'
	TD 3709'
	5" @ 3705'
6/15	TD 3712'
	Swb 3 gal oil PH
6/31	1000 acid
	Swb 4 bbls oil PH, 4 hrs.
6/28	"
7/6	"
7/12	"
7/20	"
7/27	"
8/3	TD 3712'
	Arb. 3705'
	5" @ 3705'
	1000 acid
	Pump 132 Oil / 5% W Pot
	38° Gr.
	Comp

COMPLETED

Map No. _____ Sec. 16 Twp. 21 R. 13W

Well No. 1 Grow

Westgate-Greenland Company

Contractor

SW SE


FIRST REPORT
SECTION PLAT

_____ Ft. from N. Line

330 Ft. from S. Line

_____ Ft. from E. Line

330 Ft. from W. Line

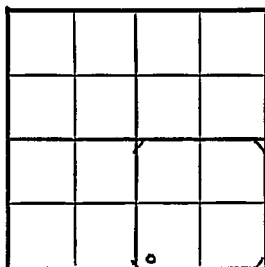

Stafford County

Location X

Rig up _____

Drilling and Remarks:

RECORD

Cased _____ in., _____ ft.

Sand _____

Gas _____

Oil _____

Total Depth _____

PRODUCTION

1st 24 hrs. Nat. _____

1st 24 hrs. after shot _____

Gas _____ Cu. Ft.

Dry Hole _____

Abandoned _____

Date

MAY 25 1949

S. J. LEWIS

Scout

Kansas


Wildcat

Map No. K 82 Sec. 16 Twp. 21 R. 13WWell No. 1 GrowWestgate-Greenland Company

COMPLETE

Contractor 1

SW SE

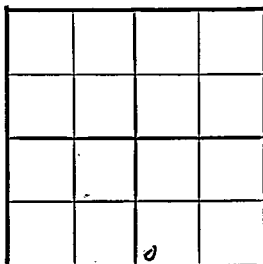E11892
SECTION PLAT Ft. from N. Line330 Ft. from S. Line Ft. from E. Line330 Ft. from W. Line

Stafford County

Location

Rig up

Drilling and Remarks:

CR X 3705
5" @ 3705
1000000
Pump 132 oil +
SW P 24
3705

RECORD

Cased in., ft.Sand Gas Oil Total Depth 3712

PRODUCTION

1st 24 hrs. Nat. 1st 24 hrs. after shot Gas Cu. Ft.Dry Hole Abandoned

Date

AUG 3 1949

19

S. J. LEWIS Scout