


DX 78-1

Stafford KANSAS

Section 16 Township 21 Range 13 W

Well No. # 1 Grow

Company Western Rig Co.

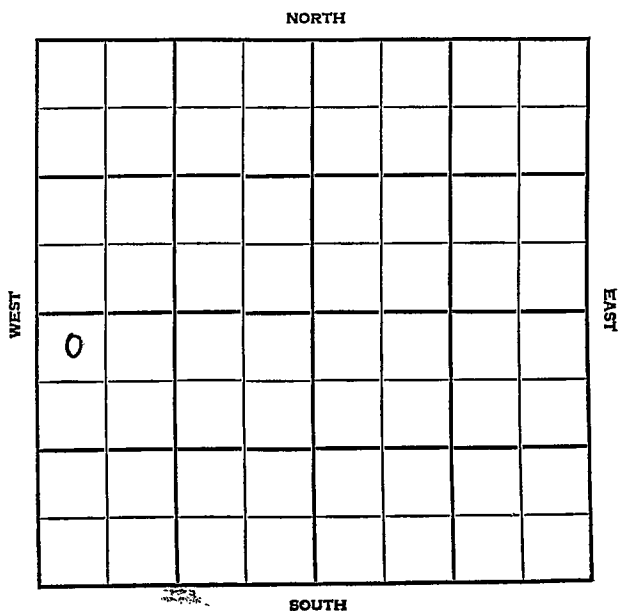

Stafford

O.W.W.O. KANSAS

Sec. 16 Twp. 21 R. 13W

Well No. #1 Grow Farm

Western Rig Company

Bud Edwards - Contr. Contractor


330' Ft. from N. Line

Ft. from S. Line

Ft. from E. Line

330' Ft. from W. Line

NW NW SW

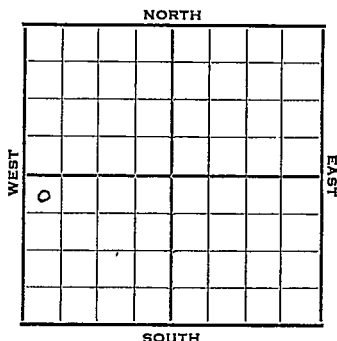

1952 Elev. 1901' REPORT

4/23 Spud 4-18-52
8" @ 280
Drlg. 1680'

4/30 Lans. 3340'
DST 3411-18, 20 mins, 180' oil,
1238#
Drlg. 3495'.

5/7 Arb. 3676-SO RTD 3735
5" @ 3735 GO 3702
24/3677-80 Fill up 3000' oil 4 hrs.
S/50 BOPH for 3 hrs. 1500' off btm
tub & rods

5/14 NR

5/21 "

5/28 Spud 4-18-52 Oil Well TD 3735'
8" @ 280 Heeb. 3208 Lans. 3340
DST 3411-18 open 20 min. rec. 180' oil
Arb. 3676 TD 3735 5" @ 3735'
GO to 3702' 24/ 3677-80 FU 3000' oil
4 hr. S/ 50 boph Comp. 375 bopd

COMPLETED

OVER

1954

O.W.W.O.

12/29

Oil Well

TD 3735'

Lans 3340', Arb. 3675'

OTD 3735'

5" @ 3735'

PB 3500'

16/ 3414'-18' 20/ 3435-39 16/ 3469-


75 20/ 3488'-94' 2000 A S/ 16 boph

Comp 104 bopd. 41% W

FIRST REPORT

COMPLETED

County Stafford State Kansas
 Sec. 16 (Blk. 21 (Sur. 13W Map No.
 (Twp. (Rge.)
 Operator Western Rig
 Well No. 1 Farm Grow
 Elev. Location NW NW SW

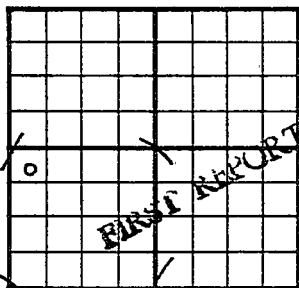

330 Ft. From N Line SW

330 Ft. From W Line Quarter

1st. Report APR 23 1952

Completion

Remarks Skelly farmout

Bud Edwards - Contr.

Spudding Date 4-18-52

Drlg. Data

8" @ 280 drlg. 1680


J. G. McGEHEE

APR 22 1952

Scout Cards	
Land Small Map	
Land Wall Map	
Tracings	
France Map	
Pierce Map	
MISC.	

Drig. Date

County Stafford State Kansas
 Sec. 16 (Blk. Twp.) 21 (Sur. Rge.) 13W Map No. _____
 Operator Western Rig
 Well No. 1 Farm Grow
 Elev. 1901 Location NW NW SW

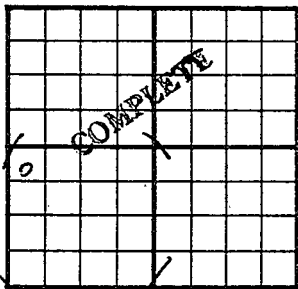

330 Ft. From N Line SW
330 Ft. From W Line Quarter

1st. Report

Completion MAY 28 1952

Remarks

Bud Edwards - Contr.

Spudding Date 4-18-52

Drlg. Data Oil well TD 3735

8" @ 280 Heeb. 3208 Lans. 3340

DST 3411-18 open 20 min. Rec. 180' oil

Arb. 3676 TD 3735 5" @ 3735 CO to 3702

24/ 3677-80 FU 3000' oil 4 hr.

S/ 50 boph Comp. 375 bopd


J. G. McGEHEE

Scout Cards
Land Small Map
Land Wall Map
Tracings
France Map
Pierce Map
Misc.

JUN 5 1952

Orig. Data

O.W.W.O.

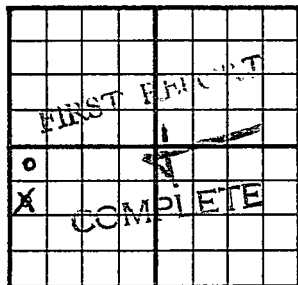County Stafford State KansasSec. 16 (Blk.) 21 (Sur.) 13W Map No.Operator Western Rig Co.Well No. 1 Farm GrowElev. Location NW SW330 Ft. From N Line SW330 Ft. From W Line Quarter1st. Report DEC 22 1954Completion DEC 22 1954Remarks O.W.W.O.Spudding Date O.W.W.O.Drlg. Data Oil well TD 3735Lans. 3340 Arb. 3675 OTD 37355" @ 3735 PB 3500 16/ 3414-1820/ 3435-39 16/ 3469-75 20/ 3488-942000 A S/ 16 boph Comp. 104 bopd 41% w

FABEN GILSTRAP

JAN 3 1955

Scout Cards	✓
Land Small Map	
Land Wall Map	
Tracings	33
France Map	
Police Map	
Misc.	

Dirig. Data