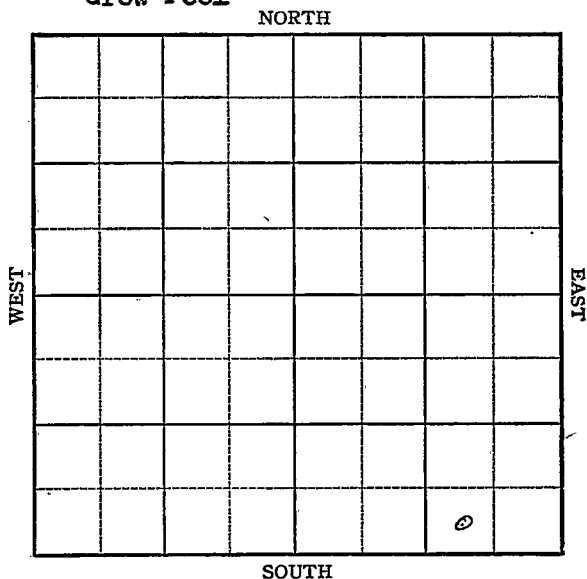


KANSAS

Stafford

O.W.W.O.Section 16 Township 21 Range 13-WWell No. #2 GrowCompany Westgate-Greenland
Grow Pool

Sec. 16 Twp. 21 R. 13WWell No. #2 Grow FarmWestgate-Greenland Company

Grow Pool

 Ft. from N. Line


330'

 Ft. from S. Line

990'

 Ft. from E. Line Ft. from W. Line

SW SE SE

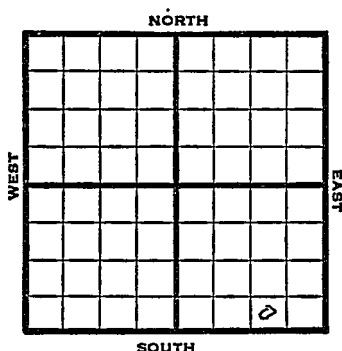

1949	Elev 1894'	REPORT
11/30	RUR	
12/7	9"@ 220'	
	Drlg 2800'	
12/14	Lansing 3320'	Arbuckle 3050
	TD 3050'	5" @ 3648'
12/21	"	
12/28	"	
1950		
2/15	TD 3657'	
	9"@ 220'	
	5"@ 3648'	
	Lans 3320'	
	Arb. 3650'	
	497 BOPD	
	Comp	
	COMPLETED	
1952		
6/18	Lans. 3320	Arb. 3650 Prod.
	OTD 3657'	5" @ 3648' DD 3662
	S/ 100 BO while C.O.	
6/25	NR	
7/2	NR	
7/9	POP	
7/17	NR	
7/23	"	
7/30	"	
8/6	"	
8/13	"	
8/20	"	

OVER

1952

8/27 Oil Well TD 3669
Lans. 3320 Arb. 3650
OTD 3657 5" @ 3648 DD 3662
S/ 100 bo TD 3669
Comp. 100 bopd

COMPLETED

Kansas

Map No. _____ Sec. 16 Twp. 21 R. 13W

Well No. 2 Grow

Westgate-Greenland

Company

Jackson

Contractor

SW SE SE

FIRST REPORT
SECTION PLAT

			0

_____ Ft. from N. Line

330 _____ Ft. from S. Line

990 _____ Ft. from E. Line

_____ Ft. from W. Line

Stafford County

Location _____

Rig up _____

Drilling and Remarks:

R U R

RECORD

Cased _____ in., _____ ft.

Sand _____

Gas _____

Oil _____

Total Depth _____

PRODUCTION

1st 24 hrs. Nat. _____

1st 24 hrs. after shot _____

Gas _____ Cu. Ft.

Dry Hole _____

Abandoned _____

Date

NOV 30 1949 19

S. J. LEWIS

Scout

Scout Cards _____
Land Small Map _____
Land Wall Map _____
Tracings _____
France Map _____
Pierce Map _____
Misc. _____

DEC 2 1949

Kansas

Map No. _____ Sec. 16 Twp. 21 R. 13W

Well No. 2 Grow

Westgate-Greenland

Company

Contractor

SW SE SE

E. 1894
SECTION PLAT


_____ Ft. from N. Line

330 _____ Ft. from S. Line

990 _____ Ft. from E. Line

_____ Ft. from W. Line

Stafford County

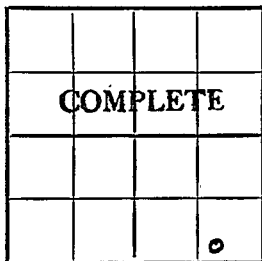

Location _____

Rig up _____

Drilling and Remarks:

9' @ 220

5' @ 3648

Lens 3320

Cub 3650

497 BOPD

RECORD

Cased _____ in., _____ ft.

Sand _____

Gas _____

Oil _____

Total Depth 3657

PRODUCTION

1st 24 hrs. Nat. _____

1st 24 hrs. after shot _____

Gas _____ Cu. Ft.

Dry Hole _____

Abandoned _____

Date


FEB 15 1950

19

J. E. TYRA

Scout

SCOUT CARDS

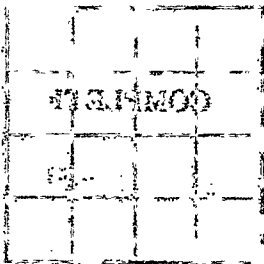

RECORD

FEB 21 1950

Scout Cards	_____
Land Small Map	_____
Land Wall Map	_____
Tracings	_____
France Map	_____
Pierce Map	_____
Misc.	_____

J. G. McGEHEE


Scout Cards	
Land Small Map	
Land Wall Map	
Tracings	
France Map	
Force Map	
Misc.	

JUN 20 1952

JUN 20 1952

Orig. Data

County Stafford State Kansas
 Sec. 16 (Blk. 21) (Sur. 13W) (Twp. 13W) Map No.
 Operator Westgate-Greenland
 Well No. 2 Farm Grow
 Elev. 1894 Location SW SE SE

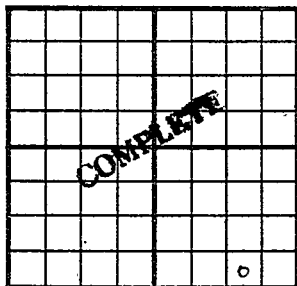

330 Ft. From S Line SE
990 Ft. From E Line Quarter

1st. Report

Completion AUG 27 1957

Remarks

Spudding Date

Drig. Data Oil well TD 3669
Lans. 3320 Arb. 3650 OTD 3657 5" @ 3648
DD 3662 S/ 100 bo TD 3669
Comp. 100 bopd

Secret Cards

Land Small Map

Land Wall Map

Tracings

France Map

Pierce Map

Misc

SEP 3 1952

Orig. Data