


Section 16 Township 21 Range 13W

Well No. #7 Grow

Company Westgate-Greenland

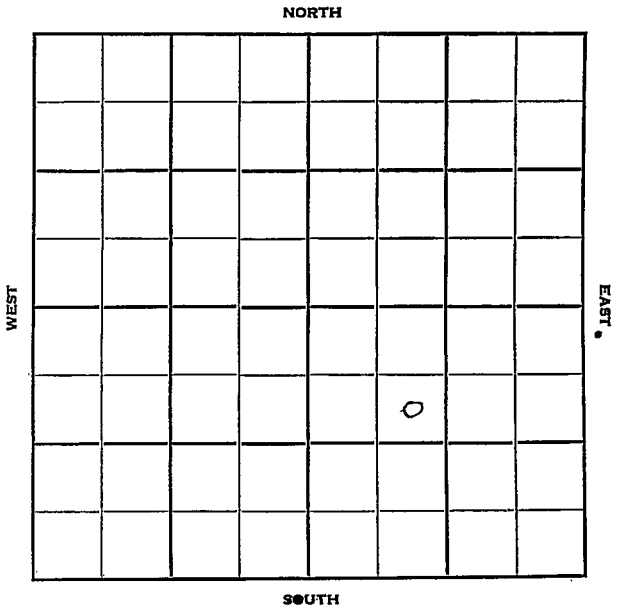

Stafford **KANSAS**  
21 R. 13W

Sec. 16 Twp. 21 R. 13W

Well No. #7 Grow Farm

Westgate-Greenland Company

Jackson Drlg. - Contr. Contractor


990' Ft. from N. Line

         Ft. from S. Line

         Ft. from E. Line

990' Ft. from W. Line

SE NW SE

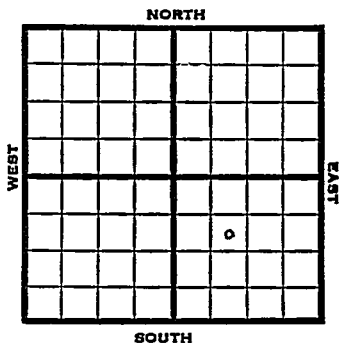

1950 Elev. 1892' REPORT

12/20 Spud 12-14-50  
8" @ 286'  
Anhy 760'  
Drlg. 2045'

1951  
2/14 Spud 12-14-50  
Oil Well TD 3660  
8" @ 286' Anhy 760'  
Br Lime 3318 Lans. 3334'  
DST 3359-79 opn 1 hr  
Rec. 25' socm Viola 3564'  
Simp. 3602' Arb. 3652-60  
5" @ 3654 TD 3660'  
1000 A S/5 boph Comp. 238 bopd.

**COMPLETED**



DEC 22 1955

Scout Cards	.....
Land Small Map	.....
Land Trail Map	.....
Tracings	.....
Fr. n. e. l. p	.....
Fr. n. e. M. n	.....
.....	.....



1961 FEB 21

FEB 21 1961

Scout Cards	.....
Land Small Map	.....
Land Wall Map	.....
Tracings	.....
France Map	.....
Pierce Map	.....
Misc.	.....

Orig. Date