

Section 16 Township 21 Range 13W

Well No. #8 Grow

Company Westgate-Greenland

NORTH

				0			

WEST

EAST

SOUTH

Sec. 16 Twp. 21 R. 13 W1

Well No. # 8 Grow Farm

Westgate-Greenland Company

Jackson Drlg. Contractor


990 Grow Pool

Ft. from N. Line

Ft. from S. Line

Ft. from E. Line

330 Ft. from W. Line

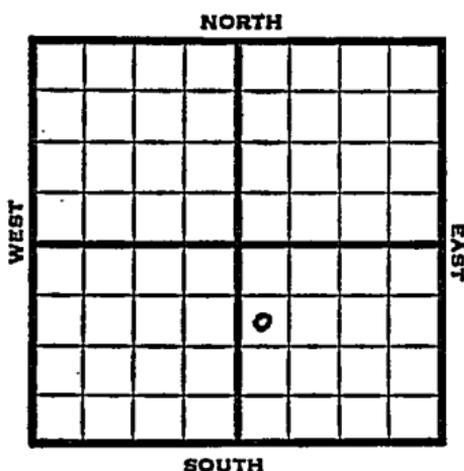

SW NW SE

1951 Elev. 1896' REPORT

2/7 Spud 2/4/51

10" @269

WOC

4/18 Spud 2-4-51

Oil Well TD 3675

10" @ 269' Anhy 760'

Heeb. 3205 Br Lime 3325

Lans. 3340 Viola 3580

Simp 3618 Arb. 3656

DST 3657-65 opn 1 hr.

Rec. 75' ho & gcm

DST 3667-73 opn 1 hr

Rec. 390' gas 810' oil

TD 3675 7" @ 3661

FU 600' oil 6 hr 1500' total

full up S/5 boph

Comp. 375 bopd

COMPLETED

County Stafford State Kansas

Sec. 16 (Blk. 21 (Sur. 13W (Twp.) Rge.) Map No.

Operator Westgate-Greenland

Well No. 8 Farm Grow

Elev. _____ Location SW NW SE

FIRST REPORT							
				0			

990 Ft. From N Line SE

330 Ft. From W Line Quarter

1st. Report FEB 7 1951

Completion _____

Remarks _____

Jackson Drils. - Contr.

Spudding Date 2-4-51

Drig. Data Grow Pool

10" @ 269 WOC

J. E. TYRA

