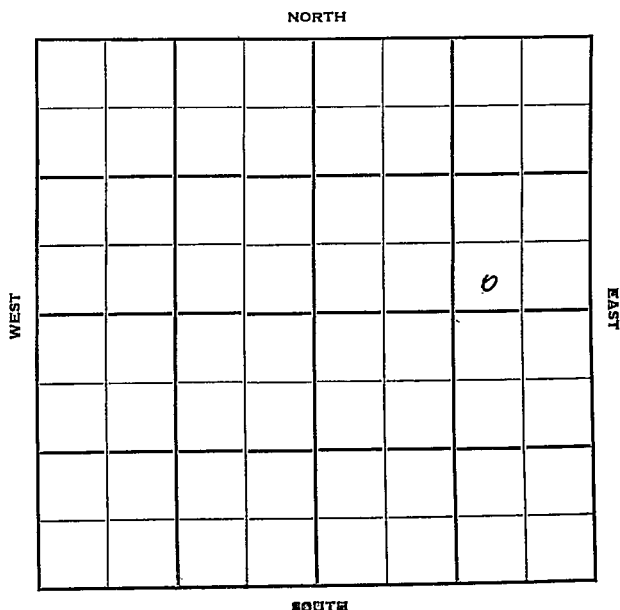


FORM 51 25M 3-49 PETROL

Section 16 Township 21 Range 13-WWell No. #1 HarmsCompany Westgate-Greenland

Stafford

KANSAS

Sec. 16 Twp. 21 R. 13W 

Well No. #1 Harms Farm

Westgate-Greenland Company

Grove Pool Contractor


 Ft. from N. Line

330' Ft. from S. Line

990' Ft. from E. Line

 Ft. from W. Line

SW SE NE

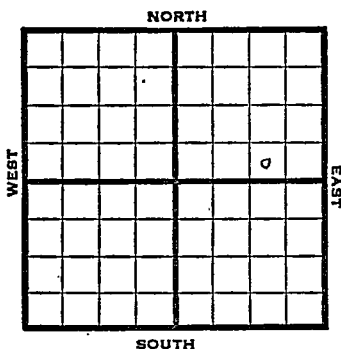

1950

Elev. 1889' REPORT

2/22

Spud 2-15-50
8-5/8" @ 277'
Drlg. 2417'

3/29

TD 3635'
8 5/8" @ 277'
5" @ 3631'
Lans 3322'
Viola 3547'
Simp 3577'
Simp 3577'
Arb. 3630'
573 BOPD
Comp

COMPLETED

Map No. _____ Sec. 16 Twp. 21 R. 13WWell No. 1 HarmsWestgate-Greenland

Company

Contractor

SW SE NE

El. 1889

SECTION PLAT



_____ Ft. from N. Line

330 Ft. from S. Line990 Ft. from E. Line

_____ Ft. from W. Line

Stafford County

Location _____

Rig up _____

Drilling and Remarks:

Spud 2-15-50

8 5/8" @ 277

drlg. 2417

RECORD

Cased _____ in., _____ ft.

Sand _____

Gas _____

Oil _____

Total Depth _____

PRODUCTION

1st 24 hrs. Nat. _____

1st 24 hrs. after shot _____

Gas _____ Cu. Ft.

Dry Hole _____

Abandoned _____

Date

FEB 22 1950

19

J. E. TYRA

Scout

Kansas

Map No. _____ Sec. 16 Twp. 21 R. 13WWell No. 1 Harms

_____ Westgate-Greenland _____ Company

_____ Contractor


SW SE NE

E1. 1889
SECTION PLAT

_____ Ft. from N. Line

330 Ft. from S. Line990 Ft. from E. Line

_____ Ft. from W. Line

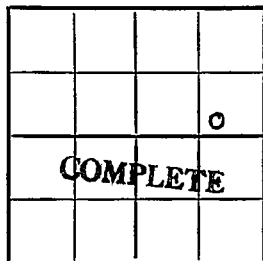

Stafford County

Location _____

Rig up _____

Drilling and Remarks:

8 5/8" @ 277

5" @ 3631

Lans 3322

Vigla 3547

Simp 3577

arb 3630

RECORD

Cased _____ in., _____ ft.

Sand _____

Gas _____

Oil _____

Total Depth 3635

PRODUCTION

1st 24 hrs. Nat. _____

1st 24 hrs. after shot _____

Gas _____ Cu. Ft.

Dry Hole _____

Abandoned _____

Date

573 BOPD 6

MAR 29 1950

J. E. TYRA

Scout