


Section 16 Township 21 Range 13WWell No. #1 Keenan Est.Company Westgate-Greenland

NORTH

WEST

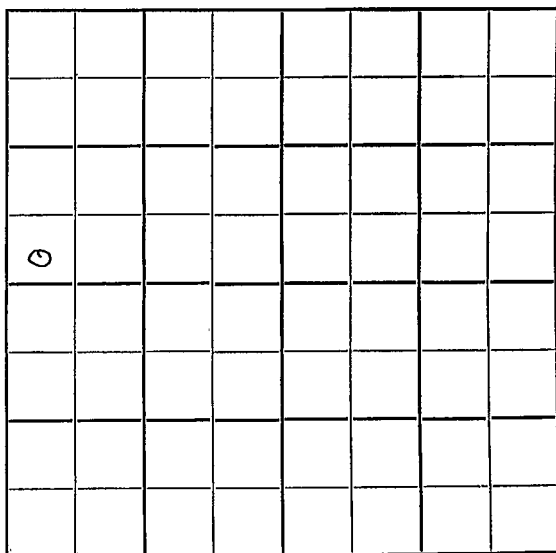

EAST

SOUTH

Stafford

KANSAS

Sec. 16 Twp. 21 R. 13W

Well No. #1 Keenan Estate ☒ Farm

Westgate-Greenland Company

Jackson Drlg. - Contr. Contractor

Grow Pool


 Ft. from N. Line

330' Ft. from S. Line

 Ft. from E. Line

330' Ft. from W. Line

SW SW NW

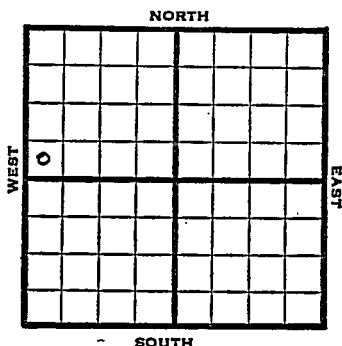


1952

Elev. 1903' REPORT

5/14 Spud 5-13-52
5/21 8" @ 276'
Anhy 784'
Drlg. 2770'

5/28 Spud 5-13-52
D&A TD 3735 8" @ 276'
Anhy 784' Heeb. 3217
Br Li 3339 Lans. 3352
Arb. 3720
TD 3735' lost surface pipe in hole
D&A

ABANDONED

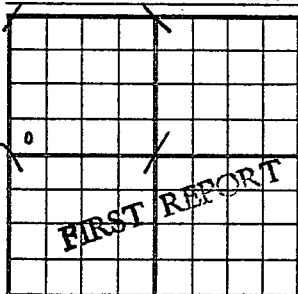County Stafford State KansasSec. 16 (Blk. Twp.) 21 (Sur. Rge.) 13W Map No.Operator Westgate-GreenlandWell No. 1 Farm Keenan estateElev. Location SW SW NW330 Ft. From S Line NW330 Ft. From W Line Quarter1st. Report MAY 14 1952


Completion

Remarks

Jackson Drlg. - Contr.Spudding Date 5-13-52Drlg. Data Grow Pool

J. G. McGEHEE

County Stafford State Kansas
 Sec. 16 (Blk. 21 (Sur. 13W Map No.
 (Twp.) (Rge.)
 Operator Westgate-Greenland
 Well No. 1 Farm Keenan Estate
 Elev. 1903 Location SW SW NW

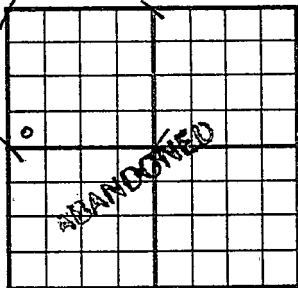

330 Ft. From S Line NW
330 Ft. From W Line Quarter

1st. Report

Completion MAY 28 1952

Remarks Grow Pool
Jackson Drlg. - Contr.

Spudding Date 5-13-52

Drlg. Data D & A TD 3735

8" @ 276 Anhy 784 Heeb. 3217

Br. lime 3339 Lans. 3352 Arb. 3720

TD 3735 lost surface pipe in hole
D & A