


Section 16 Township 21 Range 14 W

Well No. # 1 Boyer

Company Petroleum Inc. et al

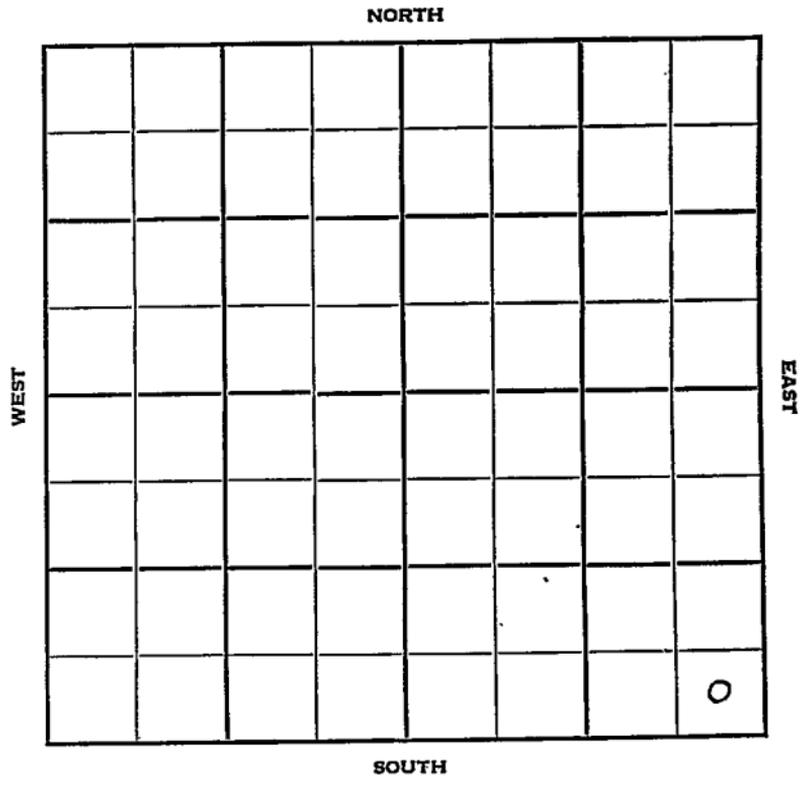

Sec. 16 Twp. 21 R. 11 W

Well No. # 1 Boyer Farm

Petroleum Inc. et al Company

Contractor

Wildcat


 Ft. from N. Line

330 Ft. from S. Line

330 Ft. from E. Line

 Ft. from W. Line

SE SE SE

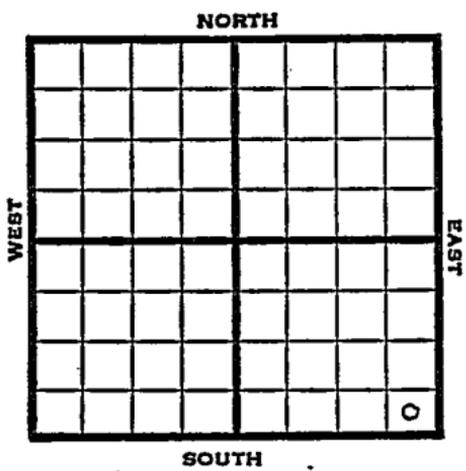

1951 Elev. 1937' REPORT

4/18 Spud 4-13-51
8" @ 226
Drlg. 2110'

7/11 Spud 4-13-51
Oil well TD 3762' 8" @ 226'
Anhy 856' Heeb 3266' Br line 3382'
Lans. 3394',
DST 3509-25 open 1 hr. rec 50' mud & water
DST 3534-64 open 1 hr. rec 180' OCM
50' HOCM, 30' mud & water
DST 3575-3620 open 45 min. rec 35' mud
B KC 3626' Cong 3651' Viola 3656
Arb. 3742'
DST 3743-46 open 1 hr. rec 150' HOCM
60' SW TD 3762' 5" @ 3761
4/3747-48 250 A S/4 BFPH
33/3558-66 500 A S/7 BO 6% wtr
35/3558-66 500 A S/12 BOPH
12% water. S/8 BOPH 6% water
Comp. 183 BOPD 8% water

COMPLETED

