

KANSAS

FORM 51 5M 10-41 PETROL


Stafford

Section 16 Township 21 Range 14-W

Well No. #1 Koehn & Laudick

Company Vickers & Atlantic

Wildcat

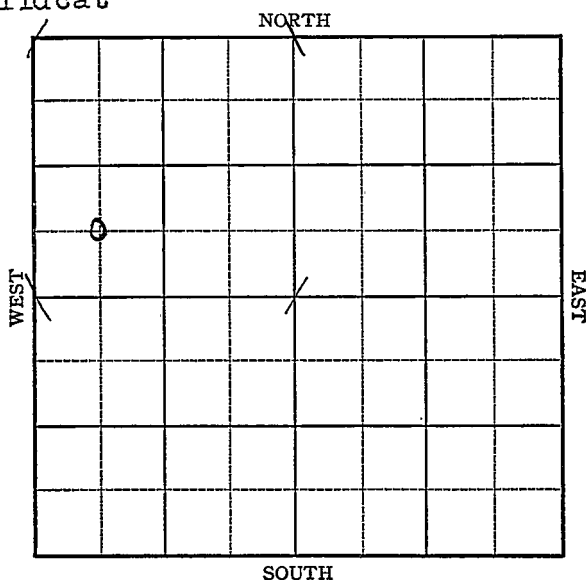

KANSAS

Stafford

Sec. 16 Twp. 21 R. 14-W

Well No. #1 Kochn & Laudick Farm

Vickers & Atlantic Company

Wildcat


 Ft. from N. Line

660

 Ft. from S. Line

 Ft. from E. Line

660 Ft. from W. Line

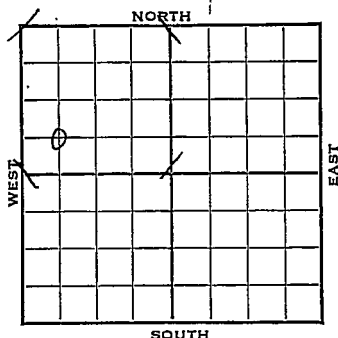

C SW NW E. l. w. 1938

1942

REPORT

12/2 Loc.

12/9 "

12/16 8" @ 824
WOC

12/22 Anhy 860
Drlg. 2940'

12/29 Lans. 3414
Viola 3683
Simpson 3720
Arb. 3785
T.D. 3836'
No shows.

ABANDONED

Map No. 82 Sec. 16 Twp. 21 R. 14W


Well No. 1 Koehn & Laudick

Vickers & Atlantic Company

FIRST REPORT Contractor

C SW NW

SECTION PLAT

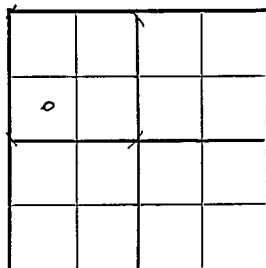

 Ft. from N. Line

660 Ft. from S. Line

 Ft. from E. Line

660 Ft. from W. Line

WILDCAT

Location XXX

Rig up

Drilling and Remarks:

RECORD

Cased in., ft.

Sand

Gas

Oil

Total Depth

PRODUCTION

1st 24 hrs. Nat.

1st 24 hrs. after shot

Gas Cu. Ft.

Dry Hole

Abandoned

Date

DEC 2 1942 19 S. J. LEWIS Scout

Stafford

KANSAS

Map No. 82 Sec. 16 Twp. 21 R. 14WWell No. 1 Koehn & LaudickVickers & Atlantic CompanyABANDONED Contractor

C SW NW

SECTION PLAT

 Ft. from N. Line660 Ft. from S. Line Ft. from E. Line660 Ft. from W. Line

o			

WILDCAT

Location Rig up

Drilling and Remarks:

*Lane 3414**Viola 3683**Simpson 3720**Co. 3785**No shows*

RECORD

Cased in., ft.Sand Gas Oil Total Depth 3786

PRODUCTION

1st 24 hrs. Nat. 1st 24 hrs. after shot Gas Cu. Ft.Dry Hole Abandoned

Date

DEC 29 1942S. J. LEWIS Scout