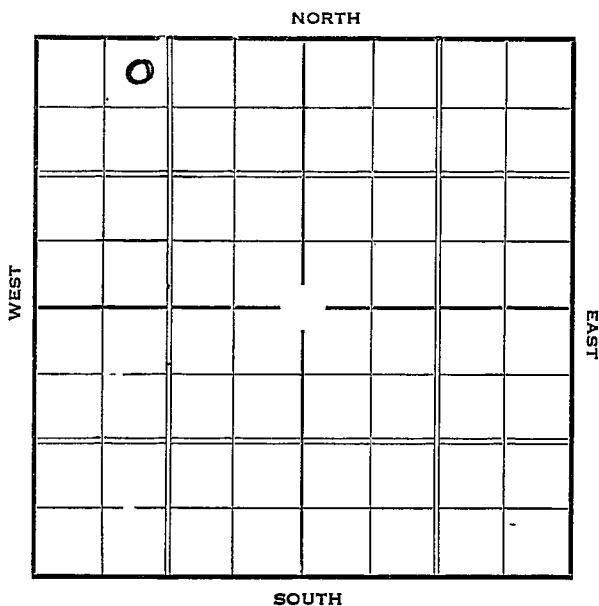


Section 16 Township 21 Range 7-WWell Number 3 PattonCompany Reserve Development

KANSAS *Rice*Map No. *49* Sec. *16* Twp. *21* R. *7W*Well No. *3 Patton**Reserve Development* Company

Contractor

SECTION PLAT

<i>0</i>			

330 Ft. from N. Line

_____ Ft. from S. Line

_____ Ft. from E. Line

990 Ft. from W. Line

FIRST REPORT

Location _____

Rig up _____

Drilling and Remarks:

Rig

RECORD

Cased _____ in., _____ ft.

Sand _____

Gas _____

Oil _____

Total Depth _____

PRODUCTION

1st 24 hrs. Nat. _____

1st 24 hrs. after shot _____

Gas _____ Cu. Ft.

Dry Hole _____

Abandoned _____

Date

MAR 31 1937

19

S. J. LEWIS

Scout

Rice KANSASMap No. *49* Sec. *16* Twp. *21* R. *7 W*Well No. *3 - Patton**Reserve Development* Company

Contractor

COMPLETED

SECTION PLAT

0			

330 Ft. from N. Line

_____ Ft. from S. Line

_____ Ft. from E. Line

290 Ft. from W. Line

Location _____

Rig up _____

Drilling and Remarks:

*Flowed 490/6 hrs**POT 1852*

RECORD

Cased *7* in. *3355* ft.*5" Liner 3375*
Sand *cong 3376*

Gas _____

Oil _____

Total Depth *3382*

PRODUCTION

1st 24 hrs. Nat. _____

1st 24 hrs. after shot _____

Gas _____ Cu. Ft.

Dry Hole _____

Abandoned _____

Date

MAY 12 1937 19

H. D. Hatfield

Scout