


Section 16 Township 21 Range 7-W

Well Number 1 H. R. Patton

Company Reserve Oil & Dev.

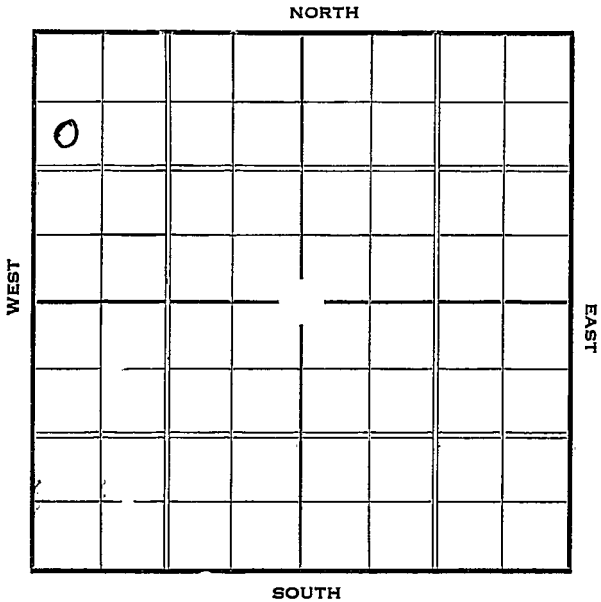

Map No. _____ Sec. 16 Twp. 21 R. 7W

Well No. 1 H. R. Patton

Reserve Oil & Gas Company

Contractor _____

SECTION PLAT

990 Ft. from N. Line

_____ Ft. from S. Line

_____ Ft. from E. Line

330 Ft. from W. Line

0			

FIRST REPORT

Location _____

Rig up _____

Drilling and Remarks:

ROG

RECORD

Cased _____ in., _____ ft.

Sand _____

Gas _____

Oil _____

Total Depth _____

PRODUCTION

1st 24 hrs. Nat. _____

1st 24 hrs. after shot _____

Gas _____ Cu. Ft.

Dry Hole _____

Abandoned _____

Date

FEB 10 1937

19

S. J. LEWIS Scout

KANSAS *Rice*Map No. _____ Sec. 16 Twp. 21 R. 7W.Well No. 1 H. R. PattonReserve Oil Development Company

Contractor

SECTION PLAT

o			

990 Ft. from N. Line

_____ Ft. from S. Line

_____ Ft. from E. Line

330 Ft. from W. Line**COMPLETED**

Location _____

Rig up _____

Drilling and Remarks:

*Conglomerate
3371**Potential**3970 natural***RECORD**

Cased _____ in., _____ ft.

Sand _____

Gas _____

Oil _____

Total Depth 3375**PRODUCTION**

1st 24 hrs. Nat. _____

1st 24 hrs. after shot _____

Gas _____ Cu. Ft.

Dry Hole _____

Abandoned _____

Date

MAR 31 1937

19

S. J. LEWIS Scout