


Section.....16.....Township.....21.....Range.....7-W.....

Well Number.....5 - H. R. Patton.....

Company.....Reserve Development.....

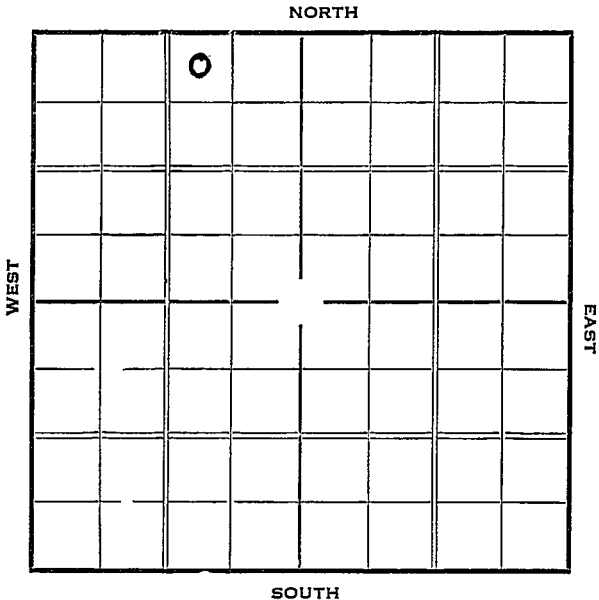

Rice

Sec. 16 Twp. 21 R. 7-W

Well No. #5 H. R. Patton Farm

Reserve Development Company


330 Ft. from N. Line

_____ Ft. from S. Line

990 Ft. from E. Line

Ft. from W. Line

Elev. 1617

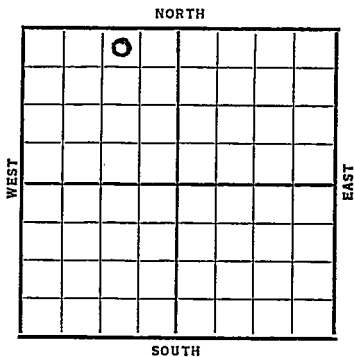[illegible]

Rice KANSASMap No. *49* Sec. *16* Twp. *21* R. *7^W*Well No. *5-H, R. Patton**Reserve Development* Company

Contractor

FIRST REPORT

330 Ft. from N. Line

_____ Ft. from S. Line

99.0 Ft. from E. Line

_____ Ft. from W. Line

SECTION PLAT

	0		

Location _____

Rig up _____

Drilling and Remarks:

Cellar

RECORD

Cased _____ in., _____ ft.

Sand _____

Gas _____

Oil _____

Total Depth _____

PRODUCTION

1st 24 hrs. Nat. _____

1st 24 hrs. after shot _____

Gas _____ Cu. Ft.

Dry Hole _____

Abandoned _____

Date

MAY 12 1937

19

H. D. Hatfield

Scout

Map No. 49 Sec. 16 Twp. 21 R. 7^WWell No. 5-H R PattonReserve Development Company

Contractor

COMPLETED

330 Ft. from N. Line Ft. from S. Line990 Ft. from E. Line Ft. from W. Line

SECTION PLAT

	0		

Location Rig up

Drilling and Remarks:

flowed 1348/6 hrsPot - 5109

RECORD

Cased 7 in., 3362 ft.Sand cong 3362Gas Oil Total Depth 3377

PRODUCTION

1st 24 hrs. Nat. 1st 24 hrs. after shot Gas Cu. Ft.Dry Hole Abandoned

Date

JUN 9 1937 19H. D. Hatfield Scout