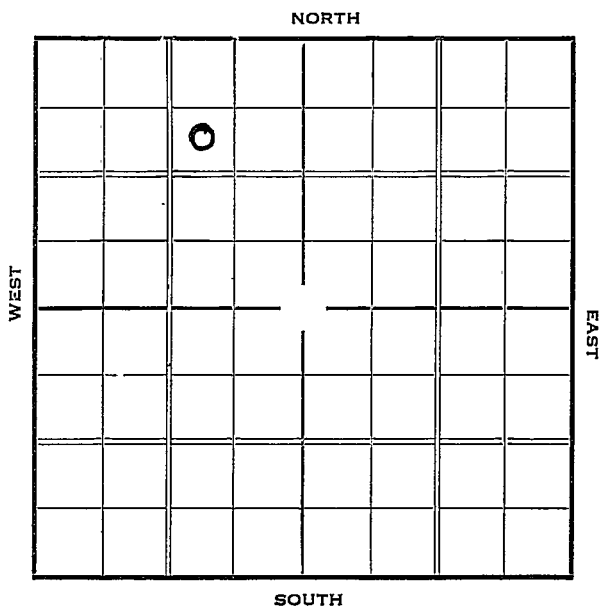



Rice

KANSAS

Section 16 Township 21 Range 7-WWell Number 6 - H. R. PattonCompany Reserve Development

Sec. 16 Twp. 21 R. 7-WWell No. #6 H. R. Patton FarmReserve Development Company990 Ft. from N. Line Ft. from S. Line990 Ft. from E. Line Ft. from W. Line

Elev. 1615

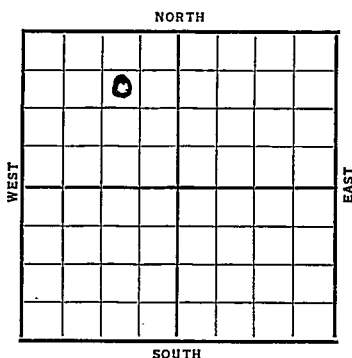

Date

REPORT

1937

5/19

Cellar

5/28

B.R.

6/4

10" @ 103'. WOC.

6/11

Drlg. 2875'.

6/19

Cong. & 7" @ 3374'. RUST.

6/23

7" @ 3374'.

Cong. 3374'.

T.D. 3380'.

Flowed 470 bbls. 6 hrs.

Pot. 1781 bbls.

COMPLETED

Rice KANSAS

Map No. 49 Sec. 16 Twp. 21 R. 7^WWell No. 6-H. R. PattonReserve Development Company

Contractor

A FIRST REPORT

990 Ft. from N. Line

_____ Ft. from S. Line

990 Ft. from E. Line

_____ Ft. from W. Line

SECTION PLAT

	0		

Location _____

Rig up _____

Drilling and Remarks:

cellar

RECORD

Cased _____ in., _____ ft.

Sand _____

Gas _____

Oil _____

Total Depth _____

PRODUCTION

1st 24 hrs. Nat. _____

1st 24 hrs. after shot _____

Gas _____ Cu. Ft.

Dry Hole _____

Abandoned _____

Date

MAY 19 1937

19

L. D. Hatfield

Scout

Map No. 49 Sec. 16 Twp. 21 R. 7 WWell No. 6 - H.R. PattonReserve Development Company

Contractor

COMPLETED

SECTION PLAT

990 Ft. from N. Line

_____ Ft. from S. Line

990 Ft. from E. Line

_____ Ft. from W. Line

	0		

Location _____

Rig up _____

Drilling and Remarks:

flowed 470/6 hrs
Pat - 1781

RECORD

Cased 7 in., 3374 ft.Sand Comp 3374

Gas _____

Oil _____

Total Depth 3380

PRODUCTION

1st 24 hrs. Nat. _____

1st 24 hrs. after shot _____

Gas _____ Cu. Ft.

Dry Hole _____

Abandoned _____

Date

JUN 23 1937 19

H. D. Hatfield Scout