
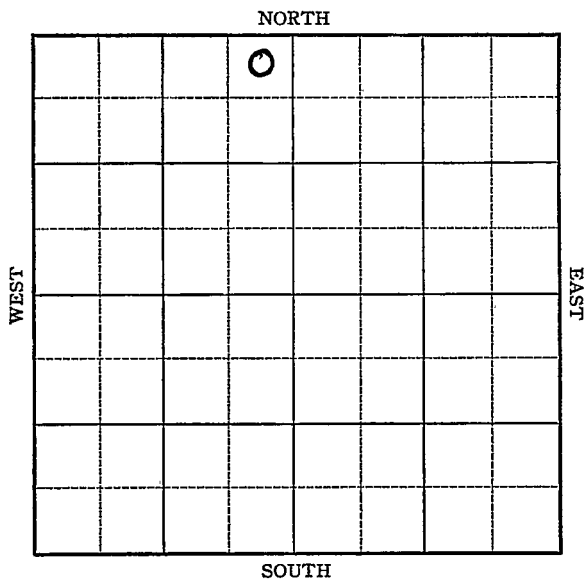


Section 16 Township 21 Range 7-WWell No. 7 - H. R. PattonCompany Reserve Development

Sec. 16 Twp. 21 R. 7-WWell No. #7 H. R. Patton Farm  
Reserve Development Company330 Ft. from N. Line       Ft. from S. Line330 Ft. from E. Line       Ft. from W. Line

Elev. 1612

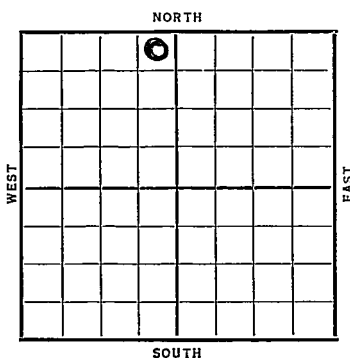

Date

REPORT

1937

6/9 Location

6/19 R U R

6/25 10" @ 98'. Drlg. 2005'.

7/2 Cong. &amp; 7" @ 3368'.

T.D. 3370'. RUST.

7/7 7" @ 3368'.

Cong. 3368'.

T.D. 3388'.

Flowed 1084 bbls. 6 hrs.

Potential 4108 bbls.

**COMPLETED**

*Rice* **KANSAS**Map No. 49 Sec. 16 Twp. 21 R. 7<sup>W</sup>Well No. 7 - H. P. PattonReserve Development Company

Contractor

## FIRST REPORT

## SECTION PLAT

330 Ft. from N. Line     Ft. from S. Line330 Ft. from E. Line     Ft. from W. Line

|  |   |  |  |
|--|---|--|--|
|  | 0 |  |  |
|  |   |  |  |
|  |   |  |  |
|  |   |  |  |

Location ✓Rig up     

Drilling and Remarks:

## RECORD

Cased      in.,      ft.Sand     Gas     Oil     Total Depth     

## PRODUCTION

1st 24 hrs. Nat.     1st 24 hrs. after shot     Gas      Cu. Ft.Dry Hole     Abandoned     

Date

JUN 9 1937

19

H. D. Hatfield Scout

Rice KANSAS

Map No. 49 Sec. 16 Twp. 21 R. 7<sup>W</sup>Well No. 7-H. D. PattonReserve Development Company

Contractor

COMPLETED

## SECTION PLAT

|  |   |  |  |
|--|---|--|--|
|  | 0 |  |  |
|  |   |  |  |
|  |   |  |  |
|  |   |  |  |

330 Ft. from N. Line

\_\_\_\_\_ Ft. from S. Line

330 Ft. from E. Line

\_\_\_\_\_ Ft. from W. Line

Location \_\_\_\_\_

Rig up \_\_\_\_\_

Drilling and Remarks:

flowed 1084/6 hrs  
Pot - 4108

## RECORD

Cased 7 in., 3368 ft.Sand cong 3368

Gas \_\_\_\_\_

Oil \_\_\_\_\_

Total Depth 3388

## PRODUCTION

1st 24 hrs. Nat. \_\_\_\_\_

1st 24 hrs. after shot \_\_\_\_\_

Gas \_\_\_\_\_ Cu. Ft.

Dry Hole \_\_\_\_\_

Abandoned \_\_\_\_\_

Date

JUL 7 1937

H. D. Hatfield

19

Scout