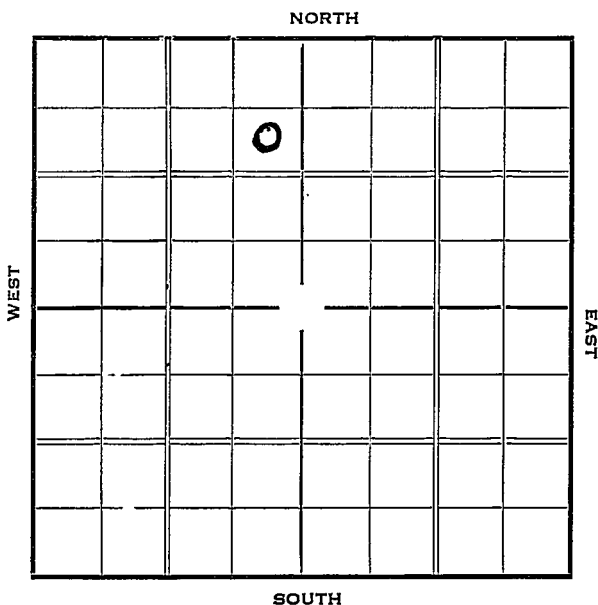



Rice

KANSAS

Section 16 Township 21 Range 7-WWell Number 8 - H. R. PattonCompany Reserve Development

Sec. 16 Twp. 21 R. 7-WWell No. #8 H. R. Patton FarmReserve Development Company990 Ft. from N. Line Ft. from S. Line330 Ft. from E. Line Ft. from W. Line

Elev. 1615

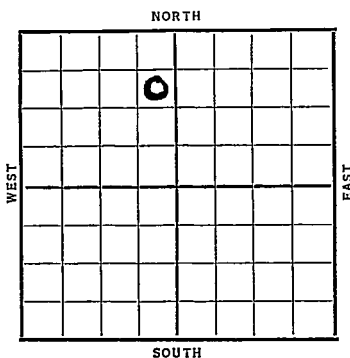

Date	REPORT
1937	
6/23	Rig on gr.
7/2	R U R
7/9	10" @ 100'. Drlg. 1090'.
7/16	7" @ 3372'. RUST.
7/23	Cong. 3372'. Drlg. 3430'.
7/30	$\frac{1}{2}$ " T.D. 3340'.
	Shot 60 qts. 3362-77'. 2500' oil. C.O.
8/6	T.D. 3430'. (Corrected) 2600' fluid. C.O.
8/13	" " " " "
8/18	7" @ 3372'.
	Cong. 3372'.
	T.D. 3430'.
	Flowed 99.3 bbls. 4 hrs.
	Pot. 596 bbls.
	COMPLETED

Rice **KANSAS** *W*

Map No. *49* Sec. *16* Twp. *21* R. *7*

Well No. *S-H-R. Patton*

Reserve Development Company

Contractor

FIRST REPORT

SECTION PLAT

990 Ft. from N. Line

_____ Ft. from S. Line

330 Ft. from E. Line

_____ Ft. from W. Line

	<i>0</i>		

Location _____

Rig up _____

Drilling and Remarks:

Rig on go.

RECORD

Cased _____ in., _____ ft.

Sand _____

Gas _____

Oil _____

Total Depth _____

PRODUCTION

1st 24 hrs. Nat. _____

1st 24 hrs. after shot _____

Gas _____ Cu. Ft.

Dry Hole _____

Abandoned _____

Date

JUN 23 1937

19

H. D. Hatfield

Scout

KANSAS

Map No. _____ Sec. 16 Twp. 21 R. 7WWell No. S-H-R. PattonReserve Development Company

Contractor _____

COMPLETED

SECTION PLAT

	0		

990 Ft. from N. Line

_____ Ft. from S. Line

330 Ft. from E. Line

_____ Ft. from W. Line

Location _____

Rig up _____

Drilling and Remarks:

flowed 99.3/4

Pot - 596

RECORD

Cased 7 in., 3372 ft.Sand Cong 3372

Gas _____

Oil _____

Total Depth 3430

PRODUCTION

1st 24 hrs. Nat. _____

1st 24 hrs. after shot _____

Gas _____ Cu. Ft.

Dry Hole _____

Abandoned _____

Date

AUG 18 1937 19

H. D. Hatfield

Scout