


Section 16 Township 21 Range 7W

Well No. #1 Stange

Company Tom Allan

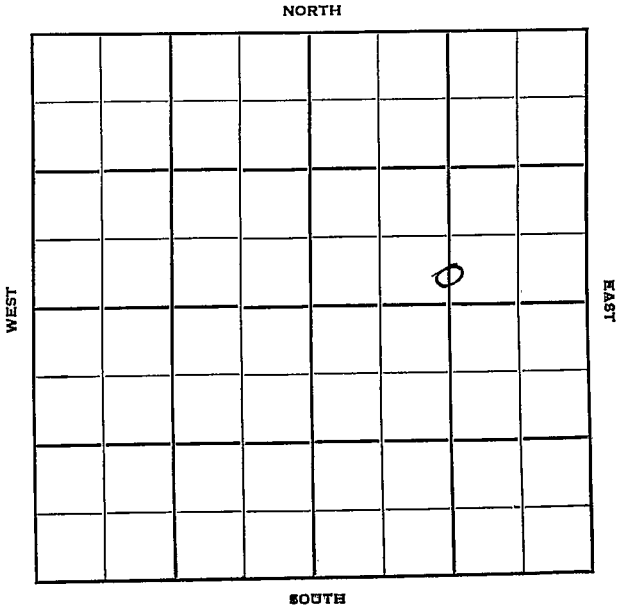

Rice

KANSAS

Sec. 16 Twp. 21 R. 7 W ✓

Well No. # 1 Stange Farm

Tom Allan Company

Wheery Pool Contractor


Ft. from N. Line

330 Ft. from S. Line

1320 Ft. from E. Line

Ft. from W. Line

C S $\frac{1}{2}$ S $\frac{1}{2}$ NE

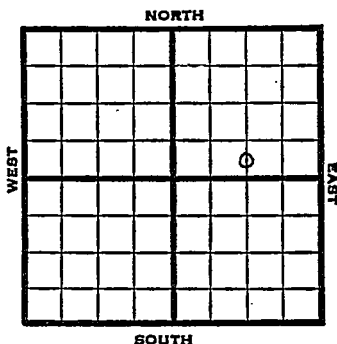

1951 Elev. 1608' REPORT

10/3 Spud 9-24-51
8" @ 195
Drilling 1538'

10/24 Spud 9-24-51
D&A TD 3399
8" @ 195
Cong. 3367-70
5" @ 3369
TD 3399 B/ 9 GOPH 55 qt/
B/ 17 GFPH 50% wtr.
D&A

ABANDONED

County Rice State Kansas

Sec. 16 (Blk. 21) (Sur. 7W) (Twp.) (Rge.) Map No.

Operator Tom Allan

Well No. 1 Farm Stange

Elev. Location C S¹/₂ S¹/₂ NE

FIRST REPORT			
		0	

330' Ft. From S Line NE

1320' Ft. From E Line Quarter

Ist. Report OCT 3 1951

Completion _____

Remarks _____

Spudding Date 9-24-51

Drlg. Data Wherry Pool

8" @ 195 drlg. 1538

County Rice State Kansas

Sec. 16 (Blk. Twp.) 21 (Sur. Rge.) 7W Map No.

Operator Tom Allan

Well No. 1 Farm Stange

Elev. 1608 Location C S $\frac{1}{2}$ S $\frac{1}{2}$ NE

ABANDONED!

330 Ft. From S Line NE

1320 Ft. From E Line Quarter

Ist. Report

Completion OCT 24 1951

Remarks Wherry Pool

Spudding Date 9-24-51

Drlg. Data D & A TD 3399

8" @ 195 Cong. 3367-70 5" @ 3369

TD 3399 B/ 9 goph . 55 qt/ B/ 17 gfph

50% water D & A