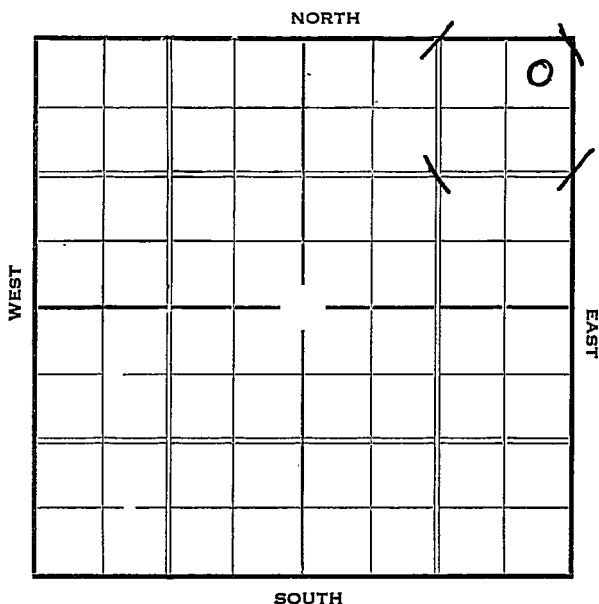
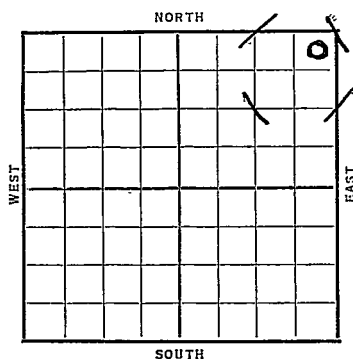


Section 16 Township 21 Range 7-WWell Number 1 StrangeCompany Garden & Haynes

Sec. 16 Twp. 21 R. 7-WWell No. #1 Strange Farm
Garden & Haynes Company330 Ft. from N. Line Ft. from S. Line330 Ft. from E. Line Ft. from W. Line*Elev. 1610*Date 1937

REPORT

<u>2/3</u>	Location
<u>2/11</u>	Rig
<u>2/18</u>	Rigging up
<u>2/26</u>	12" @ 100' Drlg. 1755'
<u>3/4</u>	Drlg. 3181'
<u>3/11</u>	Conglomerate 3375'. Set 7" RUST
<u>3/18</u>	" " " " "
<u>3/25</u>	" " " " "
<u>4/2</u>	" " " " "
<u>4/8</u>	" " " " "
<u>4/16</u>	Chat 3390'. Miss. 3426'. T.D. 3445'. 450' oil 12 hrs.
<u>4/23</u>	SD 3445'.
<u>4/30</u>	C.O.

OVER

1937

5/5

Chat 3390'.

Miss. 3426'.

T.D. 3445'.

P.B. 3390'.

Shot 40 qts. 3372-90'.

Shot 40 qts. 3406-20'.

T.D. Now 3420'.

Pot. 15 bbls.


COMPLETED

KANSAS

Map No. 49 Sec. 16 Twp. 21 R. 7WWell No. 1. StrangeGarolin & Haynes Company

Contractor

SECTION PLAT

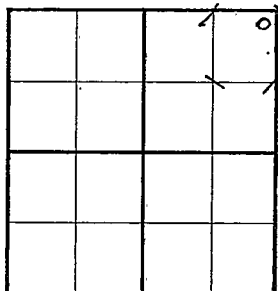380 Ft. from N. Line

_____ Ft. from S. Line

330 Ft. from E. Line

_____ Ft. from W. Line

FIRST REPORT

Location ✓

Rig up _____

Drilling and Remarks:

○

RECORD

Cased _____ in., _____ ft.

Sand _____

Gas _____

Oil _____

Total Depth _____

PRODUCTION

1st 24 hrs. Nat. _____

1st 24 hrs. after shot _____

Gas _____ Cu. Ft.

Dry Hole _____

Abandoned _____

Date

FEB 3 1937

19

S. J. LEWIS Scout

W

WMB

Paul

Preserved	_____
Cards	<i>Paul</i>
Tracing	<i>One</i>
France Map	<i>✓</i>
Scarborough Map	<i>✓</i>
Moody Map	<i>✓</i>
Scarborough Plat Book	_____
Moody Plat Book	_____

Rice KANSAS

Map No. 49 Sec. 16 Twp. 21 R. 7^WWell No. 1 - StrangeGarden & Haynes Company

Contractor

COMPLETED**SECTION PLAT**

			0

330 Ft. from N. Line

_____ Ft. from S. Line

330 Ft. from E. Line

_____ Ft. from W. Line

Location _____

Rig up _____

Drilling and Remarks:

PB, 3390

Shot 40 gts 3372-90

✓ 40 - 3406-20

T.D. now 3420

Pot 15 bbl's

RECORDCased CHAT in 3390 ft.~~Sand~~ MISS 3426

Gas _____

Oil _____

Total Depth 3445**PRODUCTION**

1st 24 hrs. Nat. _____

1st 24 hrs. after shot _____

Gas _____ Cu. Ft.

Dry Hole _____

Abandoned _____

Date

MAY 5 - 1937

19

H. D. Hatfield

Seal

45°

RDY

Returned	_____
Cards	_____
Tracing	_____
France Map	_____
Scarborough Map	_____
Moody Map	_____
Scarborough Plat Book	_____
Moody Plat Book	_____