


Section 16 Township 21 Range 7-W


Well Number 3 - Stange

Company Sunflower Oil

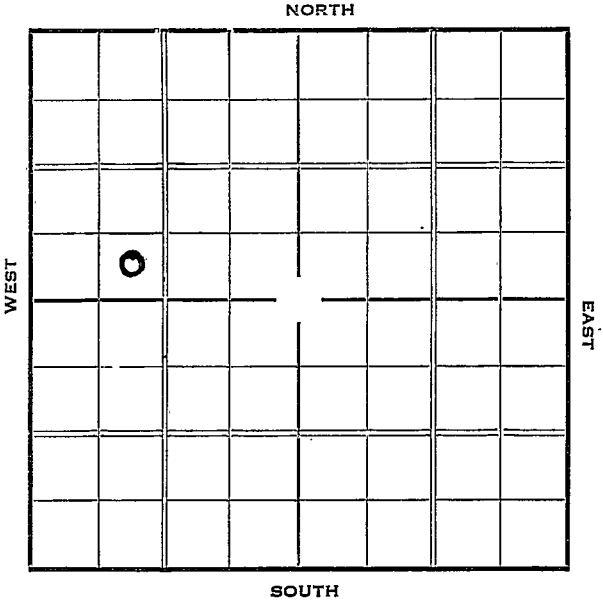

Sec. 16 Twp. 21 R. 7-WWell No. #3 Stange FarmSunflower Oil Company Ft. from N. Line330 Ft. from S. Line Ft. from E. Line990 Ft. from W. Line

Elev. 1613

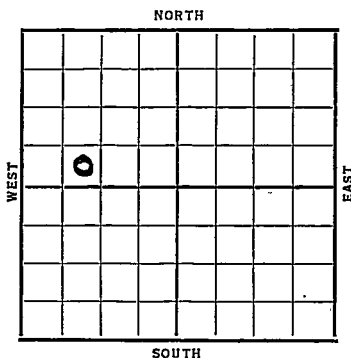

Date	REPORT
1937	
5/19	Location
5/28	12" @ 117'. WOC.
6/4	Drlg. 2360'.
6/11	Drlg. 2965'.
6/19	7" @ 3365'.
6/25	Cong. 3382'. T.D. 3460'.
	Swab & C.O.
7/2	P.B. 3397'. Shot 30 qts.
7/9	Shot 60 qts. C.O.
7/14	7" @ 3365'.
	Cong. 3382'.
	T.D. 3460'.
	P.B. 3397'.
	Shot 30 qts.
	60 qts.
	ABANDONED

Rice KANSAS

Map No. 49 Sec. 16 Twp. 21 R. 7^WWell No. 3 - StangeSunflower Oil Company

Contractor

SECTION PLAT

0			

FIRST REPORT

Ft. from N. Line

330 Ft. from S. Line

Ft. from E. Line

990 Ft. from W. LineLocation ✓

Rig up

Drilling and Remarks:

RECORD

Cased _____ in., _____ ft.

Sand _____

Gas _____

Oil _____

Total Depth _____

PRODUCTION

1st 24 hrs. Nat. _____

1st 24 hrs. after shot _____

Gas _____ Cu. Ft.

Dry Hole _____

Abandoned _____

Date

MAY 19 1937

19

H. D. Hatfield

Scout

Rice KANSASMap No. _____ Sec. 16 Twp. 21 R. 7 ^WWell No. 3 - Stange*Sunflower* Company

Contractor _____

ABANDONED

SECTION PLAT

0			

____ Ft. from N. Line

330 Ft. from S. Line

____ Ft. from E. Line

290 Ft. from W. Line

Location _____

Rig up _____

Drilling and Remarks:

*P.B. 3397**SHOT 30 gts
60 ✓**D. & A.*

RECORD

Cased 7 in., 3365 ft.Sand *cong* 3382

Gas _____

Oil _____

Total Depth 3460

PRODUCTION

1st 24 hrs. Nat. _____

1st 24 hrs. after shot _____

Gas _____ Cu. Ft.

Dry Hole _____

Abandoned _____

Date

JUL 14 1937 19*H. D. Hatfield* Scout