

Sec. 16 Twp. 21 R. 11-W

Well No. #1 C. P. Smith "B" Farm

Shell Company

(Snider)


330 Ft. from N. Line

_____ Ft. from S. Line

330 Ft. from E. Line

_____ Ft. from W. Line

Elev. 1755

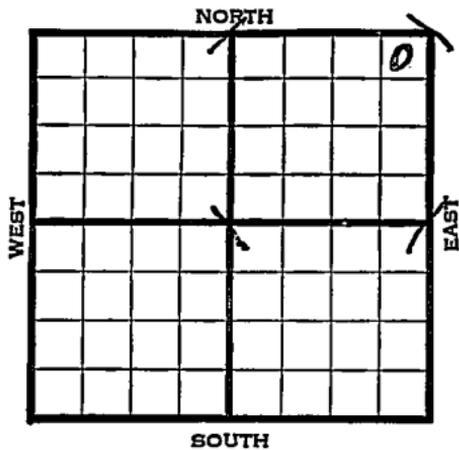

1940	REPORT
12/4	Cellar.
12/12	Rotary.
12/19	8" - 225' Drlg. 1818'
12/26	Drlg. 3107'
12/30	Arb. 36 24'
	T.D. 36 31'
	No shows.
	ABANDONED

Map No. 46 Sec. 16 Twp. 21 R. 11W

Well No. 1 C. P Smith "B"

Shell Company

Contractor

FIRST REPORT

NE/C

330 Ft. from N. Line

_____ Ft. from S. Line

330 Ft. from E. Line

_____ Ft. from W. Line

SNIDER POOL

SECTION PLAT

			0

Location _____

Rig up _____

Drilling and Remarks:

Cellar

RECORD

Cased _____ in., _____ ft.

Sand _____

Gas _____

Oil _____

Total Depth _____

PRODUCTION

1st 24 hrs. Nat. _____

1st 24 hrs. after shot _____

Gas _____ Cu. Ft.

Dry Hole _____

Abandoned _____

Date

DEC 4 1940 19

S. J. LEWIS Scout

Map No. 46 Sec. 16 Twp. 21 R. 11WWell No. 1 C. P. Smith "B"

Shell

Company

Contractor

ABANDONED

NE/C

SECTION PLAT

			o

330 Ft. from N. Line

_____ Ft. from S. Line

330 Ft. from E. Line

_____ Ft. from W. Line

SNIDER POOL

Location _____

Rig up _____

Drilling and Remarks:

*Cr # 3624**No show*

RECORD

Cased _____ in., _____ ft.

Sand _____

Gas _____

Oil _____

Total Depth 363/

PRODUCTION

1st 24 hrs. Nat. _____

1st 24 hrs. after shot _____

Gas _____ Cu. Ft.

Dry Hole _____

Abandoned _____

Date

DEC 30 1940S. J. LEWIS Scout