


Section 16 Township 21 Range 11-W

Well No. #5 Smith "B"

Company Cities Service Oil

NORTH Snider Pool

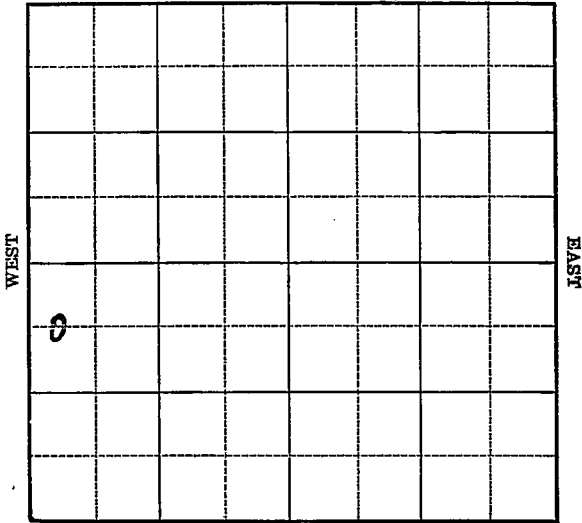

SOUTH

KANSAS .. **Stafford**

Sec. 16 Twp. 21 R. 11-W

Well No. #5 Smith "B" Farm

Cities Service Oil Company

(Snider)


_____ Ft. from N. Line

660 Ft. from S. Line

_____ Ft. from E. Line

330 Ft. from W. Line

Elev. 1762

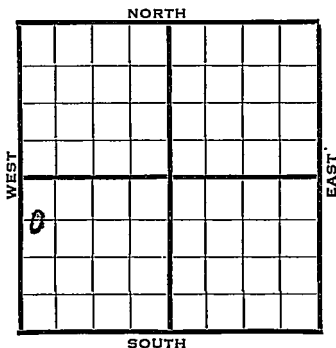

1940	REPORT
7/24	Location
8/2	10" - 323' Drlg. 1175'
8/8	Drlg. 3298'
8/14	Lans. 3128- Simp. Sand 3376'
	5" - 3377 2300' oil 8½ hrs.
8/22	70 shots 3378-85' T.D.
8/29	Potential 1630 bbls., flow.
9/5	Swab 130 bbls. 8 hours.
9/11	Lans. 3128'
	Simp. sand 3376'
	T.D. 3385'
	5" - 3377'
	70 shots 3378-85'
	Potential 1630 bbls., flow.
	COMPLETED

Map No. _____ Sec. 16 Twp. 21 R. 11W

Well No. 5 Smith "B"

Cities Service Oil Company

Contractor _____

FIRST REPORT

C W L NW SW

_____ Ft. from N. Line

660 Ft. from S. Line

_____ Ft. from E. Line

330 Ft. from W. Line

SECTION PLAT

o			

SNIDER POOL

Location X

Rig up _____

Drilling and Remarks: _____

RECORD

Cased _____ in., _____ ft.

Sand _____

Gas _____

Oil _____

Total Depth _____

PRODUCTION

1st 24 hrs. Nat. _____

1st 24 hrs. after shot _____

Gas _____ Cu. Ft.

Dry Hole _____

Abandoned _____

Date

JUL 24 1940 19

S. J. LEWIS Scout

Map No. 46 Sec. 16 Twp. 21 R. 11WWell No. 5 Smith "B"Cities Service Oil Company

Contractor

COMPLETED

C W L NW SW

 Ft. from N. Line660 Ft. from S. Line Ft. from E. Line330 Ft. from W. Line**SECTION PLAT**

o			

SNIDER POOLLocation Rig up

Drilling and Remarks:

*Lans 3128.**Simp sol 3876**5-1 @ 3377**70 Sh to 3378-85.**Flow 1630 Rx.***RECORD**Cased in., ft.Sand Gas Oil Total Depth 2385**PRODUCTION**1st 24 hrs. Nat. 1st 24 hrs. after shot Gas Cu. Ft.Dry Hole Abandoned

Date

SEP 11 1940 19S. J. LEWIS Scout