


Section 16 Township 21 Range 11W

Well No. #9 Smith "B"

Company Cities Service

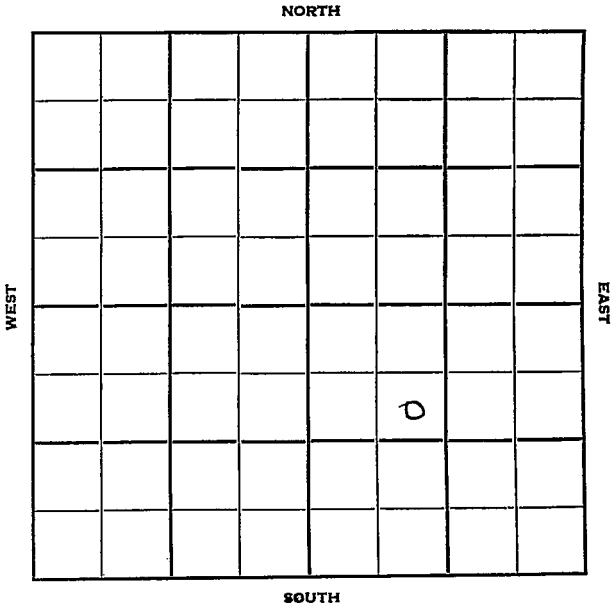

Stafford

KANSAS

Sec. 16 Twp. 21 R. 11 W

Well No. # 9 Smith "B" Farm \_\_\_\_\_

Cities Service Company \_\_\_\_\_

Contractor \_\_\_\_\_


1070 Ft. from N. Line

\_\_\_\_\_ Ft. from S. Line

\_\_\_\_\_ Ft. from E. Line

1070 Ft. from W. Line

SE NW SE

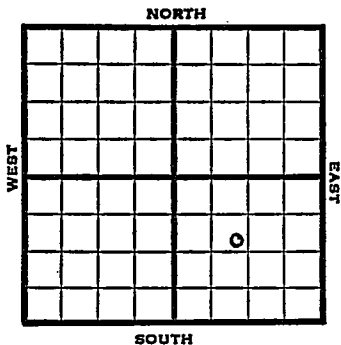

1951 Elev. 1751' REPORT

3/7 Location

3/21

Spud 3-6-51  
 D & A TD 3456'  
 8" @ 346' Doug. 3026, Br. line 3077'  
 Lans. 3097', Cong. 3368'  
 DST 3351-64 open  $\frac{1}{2}$  hr. Rec. 19' mud,  
 DST 3369-80 open  $\frac{1}{2}$  hr. Rec. 102' SW  
 Simp. 3381', Simp. sd. 3388',  
 Arb. 3426-56' TD  
 D & A

**ABANDONED**

County Stafford State Kansas

Sec. 16 (<sup>Blk.</sup><sub>Twp.</sub>) 21 (<sup>Sur.</sup><sub>Rge.</sub>) 11W Map No.

Operator Cities Service

Well No. 9 Farm Smith "B"

Elev. \_\_\_\_\_ Location SE NW SE


1070 Ft. From N Line SE

1070 Ft. From W Line Quarter

Ist. Report MAR 7 1951

Completion \_\_\_\_\_

Remarks \_\_\_\_\_

Spudding Date \_\_\_\_\_

Drlg. Data \_\_\_\_\_

Location

J. E. TYRA

