

Section 16 Township 21 Range 12-W

Well No. #1 Williams

Company Westgate-Greenland

NORTH

		0					

WEST

EAST

SOUTH

KAN

Stafford

Sec. 16 Twp. 21 R. 12-W

Well No. #1 Williams Farm

Westgate-Greenland Company

Gates _____ Contractor


330 Ft. from N. Line

_____ Ft. from S. Line

990 Ft. from E. Line

_____ Ft. from W. Line

NW NE NW

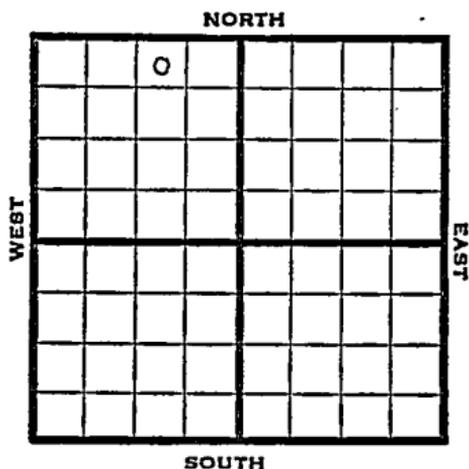

1950

E1 v. 1846' REPORT

11/1

Location

12/6

Spud 11-18-50
 D&A TD 3534
 8" @ 305' Anhy 640
 Heeb. 3080' Br Lime 3210
 Lans. 3229' Arb. 3496
 DST 3504-34 opn 60 min Rec. 75' mud
 125' wtr D&A

ABANDONED

†

County Stafford State Kansas

Sec. 16 (Blk. Twp.) 21 (Sur. Rge.) 12W Map No.

Operator Westgate-Greenland

Well No. 1 Farm Williams

Elev. _____ Location NW NE NW

330 Ft. From N Line NW

990 Ft. From E Line Quarter

1st. Report NOV 1 1950

Completion _____

Remarks _____

Spudding Date _____

Drlg. Data Gates Pool

Location _____

County Stafford State Kansas

Sec. 16 (Blk. Twp.) 21 (Sur. Rge.) 12W Map No.

Operator Westgate-Greenland

Well No. 1 Farm Williams

Elev. 1846' Location NWNE NW

330 Ft. From N Line NW

990 Ft. From E Line Quarter

1st. Report

Completion DEC 6 1950

Remarks Gates Pool

Spudding Date 11-18-50

Drig. Data D & A TD 3534

8" O 305 Anhy 640 Heeb. 3080

Br. lime 3210 Lans. 3229 Arb. 3496

DST 3504-34 open 60 min. Rec. 75' mud

125' water D & A