


Section 16 Township 21 Range 16W

Well No. 1 Webb

Company Magnolia

Wildcat
NORTH

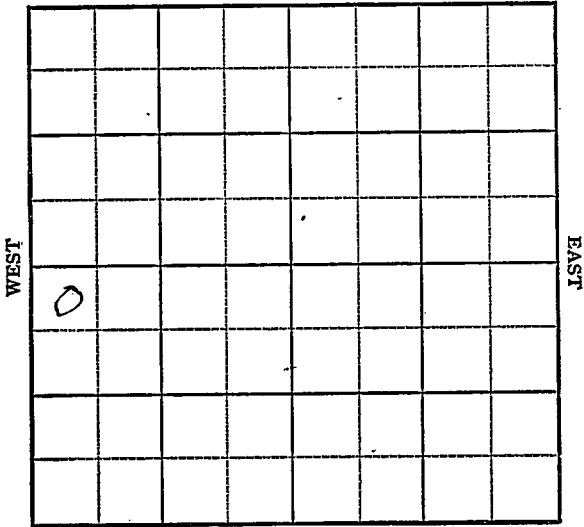

SOUTH

Sec. 16 Twp. 21 R. 16W

Well No. 1 Webb Farm

Magnolia Company

Wildcat


330 Ft. from N. Line

_____ Ft. from S. Line

330 Ft. from E. Line

_____ Ft. from W. Line

NE SW

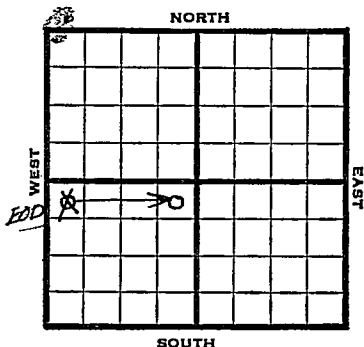

1948 Eli 1996' REPORT

- 9/1 Location
- 9/8 8" @ 1025'
- 9/14 Drlg 3130'
- 9/21 Lansing 3476'
- Viola 3769'
- Simp. 3794'
- Arbuckle 3832'
- TD 3925'
- 9/29 Viola 3769'
- Simpson 3794'
- Arb. 3832'
- TD 3925'
- Aband.*

ABANDONED

Rawnee County Kansas State

Map No. _____ Sec. 16 Twp. 21 R. 16W

Well No. 1 Webb

Magnolia Company

FIRST REPORT Contractor

NE SW

SECTION PLAT

330 Ft. from N. Line

_____ Ft. from S. Line

330 Ft. from E. Line

_____ Ft. from W. Line

Wildcat
Remarks:

Location

Date
SEP 1 1948

Scout S. J. LEWIS

Map No. 81 Sec. 16 Twp. 21 R. 16^W

Well No. 1 Webb

Magnolia Company

ABANDONED

Contractor

NE SW

E 11996

SECTION PLAT

330 Ft. from N. Line

_____ Ft. from S. Line

330 Ft. from E. Line

_____ Ft. from W. Line

		o	

Pawnee County

Location _____

Rig up _____

Drilling and Remarks:

Via la 3769
Sing 3794
Re + 3732

RECORD

Cased _____ in., _____ ft.

Sand _____

Gas _____

Oil _____

Total Depth 3925

PRODUCTION

1st 24 hrs. Nat. _____

1st 24 hrs. after shot _____

Gas _____ Cu. Ft.

Dry Hole _____

Abandoned _____

Date

SEP 29 1948 19

S. J. LEWIS Scout