

State Geological Survey

WICHITA BRANCH

15-145-20496

KANSAS DRILLERS LOG

API No. 15 — County Number

Operator

Beren Corporation

Address

970 Fourth Financial Center, Wichita, Kansas 67202

Well No.

1 Lease Name

MAGGIE "Z"

Footage Location

660 feet from ~~XX~~ (S) line

660 feet from (E) ~~XX~~ line

Principal Contractor

Sterling Drilling

Geologist

Bob Dougherty

Spud Date

12-12-77

Total Depth

2077

P.B.T.D.

Date Completed

12-16-77

Oil Purchaser


S.22 T. 21S R.17W E W

Loc. C SE SW

County Pawnee

640 Acres

N

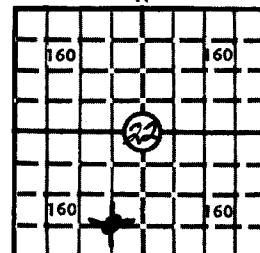

Locate well correctly

2068

Elev.: Gr.

2068

DF

KB

CASING RECORD

Report of all strings set—surface, intermediate, production, etc.

Purpose of string	Size hole drilled	Size casing set (in O.D.)	Weight lbs/ft.	Setting depth	Type cement	Sacks	Type and percent additives
Production		7"		780	60-40 Poz	350	3% CC

LINER RECORD

PERFORATION RECORD

Top, ft.	Bottom, ft.	Sacks cement	Shots per ft.	Size & type	Depth interval

TUBING RECORD

Size	Setting depth	Packer set at		

ACID, FRACTURE, SHOT, CEMENT SQUEEZE RECORD

Amount and kind of material used	Depth interval treated

INITIAL PRODUCTION

Date of first production	Producing method (flowing, pumping, gas lift, etc.)		
RATE OF PRODUCTION PER 24 HOURS	Oil bbls.	Gas MCF	Water bbls.

Disposition of gas (vented, used on lease or sold)	Producing interval(s)	Gas-oil ratio CFPB

INSTRUCTIONS: As provided in KCC Rule 82-2-125, within 90 days after completion of a well, one completed copy of this Driller's Log shall be transmitted to the State Geological Survey of Kansas, 4150 Monroe Street, Wichita, Kansas 67209. Copies of this form are available from the Conservation Division, State Corporation Commission, 3830 So. Meridian (P.O. Box 17027), Wichita, Kansas 66217. Phone AC 316-522-2206. If confidential custody is desired, please note Rule 82-2-125. Driller's Logs will be on open file in the Oil and Gas Division, State Geological Survey of Kansas, Lawrence, Kansas 66044.

Operator

Beren Corporation

DESIGNATE TYPE OF COMP.: OIL, GAS,  
DRY HOLE, SWDW, ETC.:

Well No. 1	Lease Name MAGGIE "Z"	Dry Hole
S 22 T 21 S R 17 W E W		

## WELL LOG


Show all important zones of porosity and contents thereof; cored intervals, and all drill-stem tests, including depth interval tested, cushion used, time tool open, flowing and shut-in pressures, and recoveries.

SHOW GEOLOGICAL MARKERS, LOGS RUN,  
OR OTHER DESCRIPTIVE INFORMATION.

FORMATION DESCRIPTION, CONTENTS, ETC.	TOP	BOTTOM	NAME	DEPTH
Shale	0	1071		
Anhydrite	1071	1094		
Shale	1094	1456		
Shale and Lime	1456	1994		
Shale	1994	2065		
Shale and Lime	2065	2077		

USE ADDITIONAL SHEETS, IF NECESSARY, TO COMPLETE WELL RECORD.

Date Received

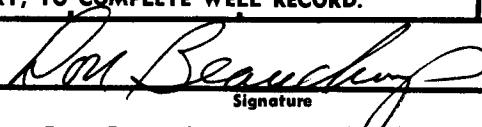
  
Signature

Don Beauchamp - Geologist

Title

March 9, 1978

Date

100118