


FORM 51 25M 3-49 PETROL

Section 17 Township 21 Range 12-W
 Well No. #1 Heaton
 Company Anschutz Drlg

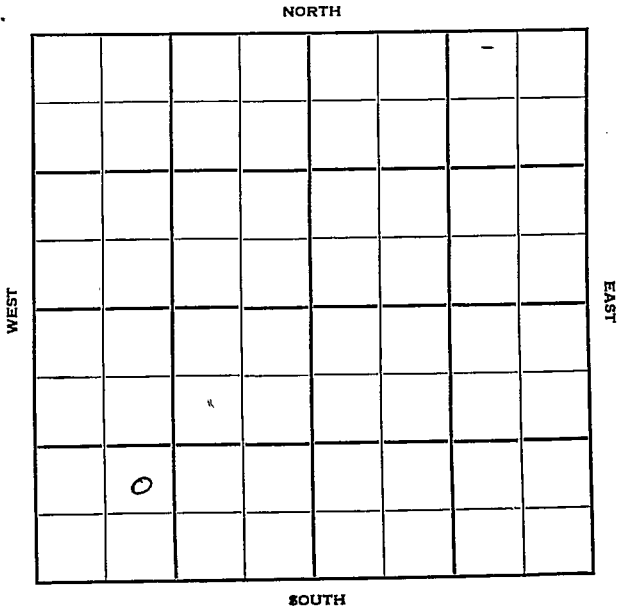

Sec. 17 Twp. 21 R. 12W

Well No. #1 Heaton Farm

Anschutz Drlg. Company

Fischer Pool


 Ft. from N. Line

990' Ft. from S. Line

 Ft. from E. Line

990' Ft. from W. Line

NE SW SW

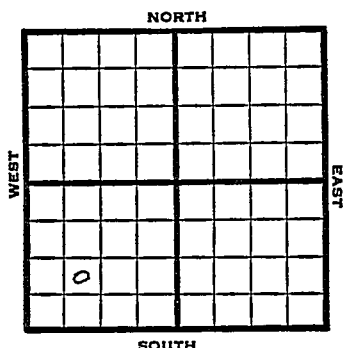

1950 Elev. 11871' REPORT

1/18 Spud 1-15-50
8" @ 307'
Drlg. 1000'

3/1 8" @ 307'
5" @ 3538'
Lans 3268'
Simp 3494'
Arb 3538'
163 BOPD
TD 3552'

COMPLETED

Kansas

Fischer Pool

Map No. _____ Sec. 17 Twp. 21 R. 12WWell No. 1 Heaton

Anschutz Drlg. _____ Company _____

Contractor _____

NE SW SW

SECTION PLAT

FIRST	REPORT		
0			

_____ Ft. from N. Line

990 Ft. from S. Line

_____ Ft. from E. Line

990 Ft. from W. Line

Stafford County

Location _____

Rig up _____

Drilling and Remarks:

Spud 1-15-50

8" @ 307

drlg. 1000

RECORD

Cased _____ in., _____ ft.

Sand _____

Gas _____

Oil _____

Total Depth _____

PRODUCTION

1st 24 hrs. Nat. _____

1st 24 hrs. after shot _____

Gas _____ Cu. Ft.

Dry Hole _____

Abandoned _____

Date

JAN 18 1950

19

J. E. TYRA Scout


Kansas

Map No. _____ Sec. 17 Twp. 21 R. 12WWell No. / HeatonAnschutz D. lg.

Company

Contractor

NE SW SW

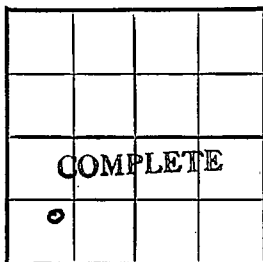E1. 181
SECTION PLAT Ft. from N. Line990 Ft. from S. Line Ft. from E. Line990 Ft. from W. Line

Stafford County

Location _____

Rig up _____

Drilling and Remarks:

8" @ 307
 5" @ 3538
 Lane 3268
 Simp 3494
 Arb 3538
 163 BOPD

RECORD

Cased _____ in., _____ ft.

Sand _____

Gas _____

Oil _____

Total Depth 3552

PRODUCTION

1st 24 hrs. Nat. _____

1st 24 hrs. after shot _____

Gas _____ Cu. Ft.

Dry Hole _____

Abandoned _____

Date

MAR 1 1950

19

J. E. TYRA

Scout