


Section 17 Township 21 Range 12 W

Well No. #1 Westafer

Company E. H. Adair

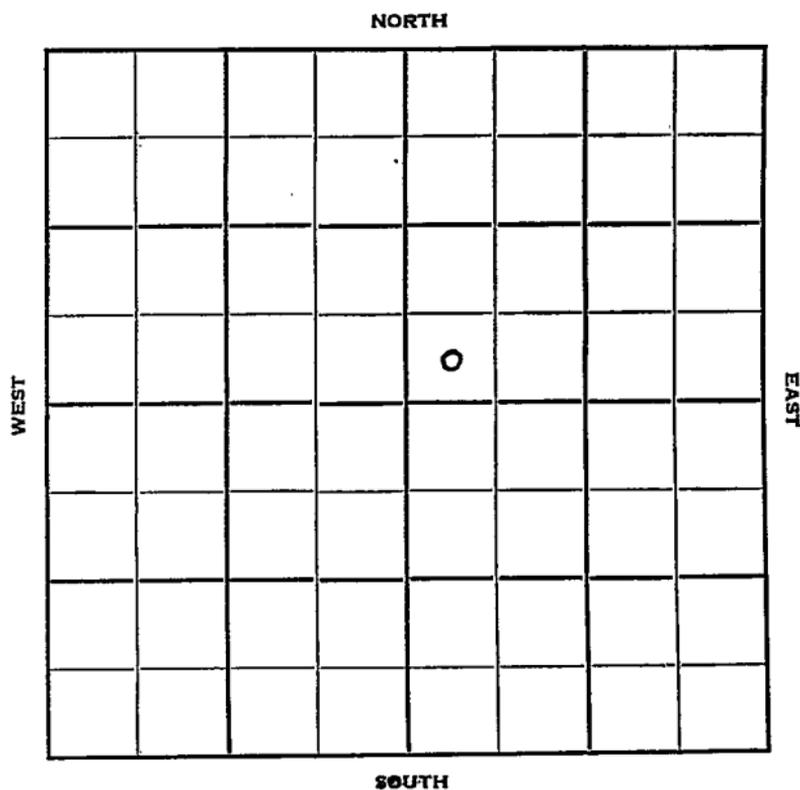

Stafford

KANSAS

Sec. 17 Twp. 21 R. 12W

Well No. #1 Westafer Farm

E. H. Adair Company

Contractor

Syms Pool


Ft. from N. Line

330 Ft. from S. Line

Ft. from E. Line

330 Ft. from W. Line

SW SW NE

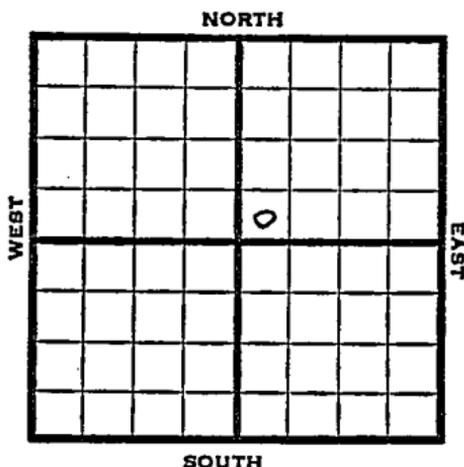

1951 Elev. 1862' REPORT

1/24 Set Surface Spud 1-21-51

2/7 Spud 1-21-51
 D&A TD 3587
 8" @ 327
 Anhy 650' Heeb. 3113
 Br Lime 3245' Lan6. 3262
 Cong. 3480' Viola 3519
 Simp. 3539' Arb. 3567'
 TD 3587' D&A

ABANDONED


County Stafford State Kansas

Sec. 17 (Blk. Twp.) 21 (Sur. Rge.) 12W Map No.

Operator E. H. Adair

Well No. 1 Farm Westafer

Elev. 1862 Location SW SW NE

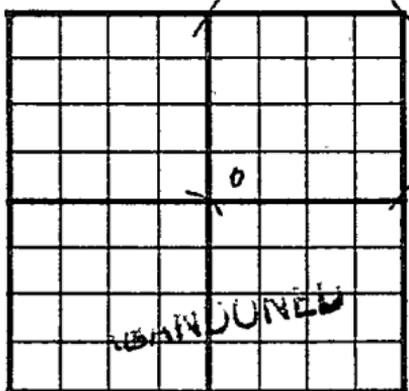

330 Ft. From S Line NE

330 Ft. From W Line Quarter

1st. Report

Completion-- FEB 7 1951

Remarks Syms Pool

Spudding Date 1-21-51

Drig. Data D & A TD 3587

8" @ 327 Anhy 650 Heeb. 3113

Br. lime 3245 Lans. 3262 Cong. 3480

Viola 3519 Simp. 3539 Arb. 3567

TD 3587 D & A

J. E. TYRA