

Section 17 Township 21 Range 12WWell No. #8 HeatonCompany Anschultz Drilling

NORTH

0							

WEST

EAST

SOUTH

Stafford

KANSAS
12W

Sec. 18 Twp. 21 R. 12W

Well No. #8 Heaton Farm

Anschultz Drlg. Company

Anschultz Contractor
Sitner


 Ft. from N. Line

990 Ft. from S. Line

 Ft. from E. Line

330 Ft. from W. Line

NW SW SW

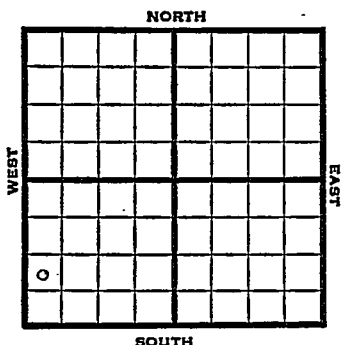

1951 Elev. 1866' REPORT

10/10 Location

1952

2/6 Heeb. 3106 Tar 3133
Br 1 3237 Lans. 3252
TD 3710 5" @ 3710

2/13 No report

2/20 "

3/5 NR

3/11 "

3/19 Spud 10-15-51
Oil Well TD 3710
8" @ 320
Heeb. 3106 Tor. 3133
Br Lime 3237 Lans. 3252
Cong. 3470 Simp 3481
Arb. 3537 TD 3710
5" @ 3710 S/19 bo 1 hr.
Comp. 306 bopd

COMPLETED

County **Stafford** State **Kansas**
 Sec. **17** (Blk. **8** Twp.) **21** (Sur. **12W** Rge.) Map No.
 Operator **Anschultz Drig.**
 Well No. **8** Farm **Heaton**
 Elev. Location **NW SW SW**

FIRST REPORT									

990 Ft. From **S** Line **SW**
330 Ft. From **W** Line Quarter

1st. Report **OCT 10 1951**

Completion

Remarks


Anschultz - Contr.

Spudding Date

Drig. Data **Sitner**

Location

County Stafford State Kansas
 Sec. 17 (Blk. 21) (Sur. 12W) Map No. 12W
 Operator Anschultz Drlg.
 Well No. 8 Farm Heaton
 Elev. 1866 Location NW SW SW

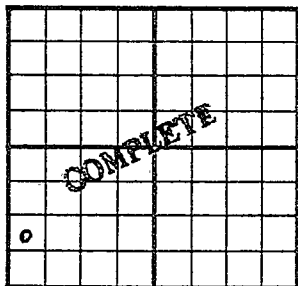

990 Ft. From S Line SW
330 Ft. From W Line Quarter
 1st. Report _____
 Completion MAR 19 1952
 Remarks Sitner Pool
Anschultz - Contr.
 Spudding Date 10-15-51

Drlg. Data Oil well TD 3710
8" @ 320 Heeb. 3106 Tor. 3133
Br. lime 3237 Lans. 3252 Cong. 3470
Simp. 3481 Arb. 3537 TD 3710
5" @ 3710 S/ 19 bo 1 hr.
Comp. 306 bopd

J. G. McGEHEE