

KANSAS

Section 17 Township 21 Range 13-WWell No. #1 FischerCompany Cities Service

NORTH

WEST

EAST

|  |  |   |  |  |  |  |  |
|--|--|---|--|--|--|--|--|
|  |  |   |  |  |  |  |  |
|  |  |   |  |  |  |  |  |
|  |  |   |  |  |  |  |  |
|  |  |   |  |  |  |  |  |
|  |  |   |  |  |  |  |  |
|  |  | 0 |  |  |  |  |  |
|  |  |   |  |  |  |  |  |
|  |  |   |  |  |  |  |  |

SOUTH

Stafford

KANSAS  
13W

Sec. 17 Twp. 21 R. 13W

Well No. #1 Fischer Farm

Cities Service Company

Holm Drlg. - Contr. Contractor

West Hazel Pool

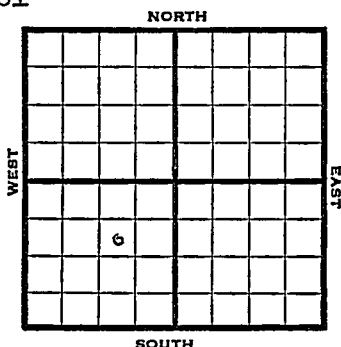
990' Ft. from N. Line

           Ft. from S. Line

990' Ft. from E. Line

           Ft. from W. Line

SW NE SW

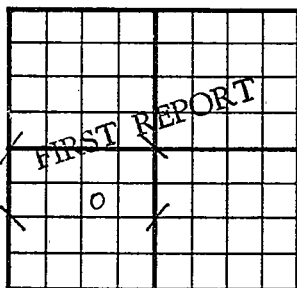


1950 Elev 1908' REPORT

10/25 Spud 10-21-50  
10" @ 560'

12/13 10" @ 560  
Lans 3342 Viola 3582  
Simp 3617 Sand 3633  
Arb 3674-80  
5" @ 3677  
DP 3680  
FU 429' oil 2 hr  
DD 3682  
FU 1417' oil 5 hr  
P/220 bopd 500 A  
P//158 bo 10½ hr  
DD 3686  
P/105 bo 6 hr 1500 A  
P/138 bo 10½ hr DD 3690  
P/113 bo 6 hr  
Comp 1847 bopd TD 3690'  
Completed

**COMPLETED**

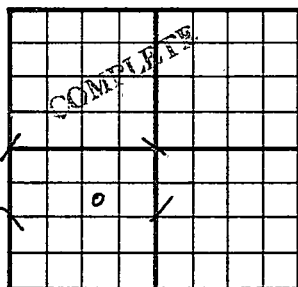
County Stafford State KansasSec. 17 (Blk. Twp.) 21 (Sur. Rge.) 13W Map No.Operator Cities ServiceWell No. 1 Farm FischerElev. Location SW NE SW990 Ft. From N Line SW990 Ft. From E Line Quarter1st. Report OCT 25 1950

Completion

Remarks

Holm Drlg. - Contr.Spudding Date 10-21-50Drlg. Data West Hazel Pool10" @ 560

J. E. TYRA

County Stafford State KansasSec. 17 (Blk. 21) (Sur. 13W) (Twp. 13W) Map No.Operator Cities ServiceWell No. 1 Farm FischerElev. 1908 Location SW NE SW990 Ft. From N Line SW990 Ft. From E Line Quarter

1st. Report

Completion DEC 13 1950Remarks West Hazel PoolHolm Drlg. - Contr.Spudding Date 10-21-50Drlg. Data Oil well TD 369010" @ 560 Lans. 3342 Viola 3582Simp. 3617 Sand 3633 Arb. 3674-805" @ 3677 DP 3680 FU 429' oil 2 hr.DD 3682 FU 1417' oil 5 hr. P/ 220 bopd500 A P/ 158 bo 10 $\frac{1}{2}$  hr. DD 3686P/ 105 bo 6 hr. 1500 A P/ 138 bo 10 $\frac{1}{2}$  hrDD 3690 P/ 113 bo 6 hr.Comp. 1847 bopd

J. E. TYRA