

Stafford
21


13 W

SECTION 17 TOWNSHIP _____ RANGE _____

WELL NO. #1 Grow

COMPANY Stanolind

NORTH

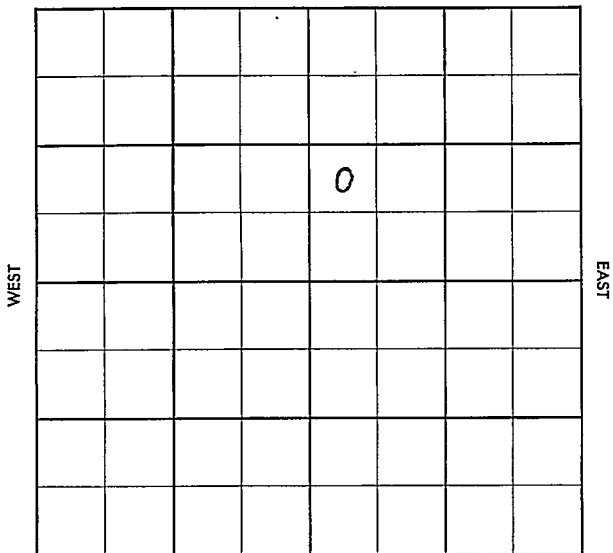

SOUTH

Stafford

KANSAS

SEC.	TWP.	R.
17	21	13W

WELL NO.

#4 Grow

FARM

COMPANY

Stanolind

CONTRACTOR

Iron Drlg.

W. Hazel


Ft. from N. Line

Ft. from S. Line

Ft. from E. Line

Ft. from W. Line

NW SW NE

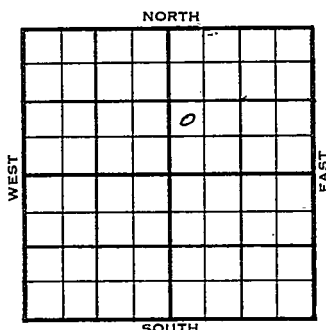

	ELEVATION	REPORT
1955	1903'	
11-23	Comm 11-18-55 8" @ 810/ 700 WOC	
12-28	DST 3398-3430 op $\frac{1}{2}$ hr. rec. 195' oil 105' mco, 990/20" DST 3454-68 op 45 min. rec. 30' g&mco 63' o&gcm, 120' gco, 890/30" 5 $\frac{1}{2}$ " @ 3669/150 CO to 3671, S/ 11 goph, 1000 A S/ 6 $\frac{1}{4}$ boph, Comp. 30 bopd, 60% wtr. Log tops: Anh. 787' H. 3198 Tr. 3217 BL. 3320 L. 3328-3330 V. 3574 S. 3609 A. 3668 TD 3671'	
COMPLETED		

TOPS	DEPTH	LOG	DATUM	Loc. in Sec.
Anh.				NW SW NE
Tr.				
H.				
Tr.				
Dg.				
Bl.				
L.				Geol.
K.C.				
B.K.C.				Contr.
Ce.				Iron Drlg.
C.				
M.				
M.				Pool
K.				W. Hazel
Mz.				
Mq.				
V.				
S.				
S.				
A.				
R.				
PE.				
G.				
TR.				

Use.

No.

NOV 23 1955

FIRST REPORT

Date Comm.	11-18-55	Sec.
	8 ¹¹ @ 810/700 WOC	

T. R.
 27

County Stafford Elev. 1903
 Sec. 17 Twp. (21) Rge. 13W
 Company Stanolind
 Farm Name Grow No. 4

TOPS /	DEPTH	LOG	DATUM	Loc. in Sec.
Anh.		787		NW SW NE
Tp.				
H.		3198	1295	
Tr.		3217	1314	
Dg.				
Bl.		3320	1417	
L.	3328	3330	1427	Geol.
K.C.				Contr.
B.K.C.				Iron Drlg.
Ce.				
C.				
M.				Pool
M.				W. Hazel
K.				
Mz.				
Me.				
V.		3574	1671	
S.		3669	1766	
S.				
A.		3668	1765	
R.				
Pf.				
G.				COMPLETE
ED.	3671			

Date Comm. 11-18-55

DEC 28 1955

8" @ 810/700 DST 3398-3430 open $\frac{1}{2}$ hr.

rec. 195' oil 105' mco 990/20"

DST 3454-68 open 45 min. rec. 30'

g & mco 63' o & gcm 120' geo 890/30"

5 $\frac{1}{2}$ " @ 3669/150 CO to 3671 S/ 11 goph1000 A S/ 6 $\frac{1}{4}$ boph Comp. 30 bopd 60% w tr