


Section 17 Township 21 Range 13W

Well No. #2 Vink

Company Cities Service

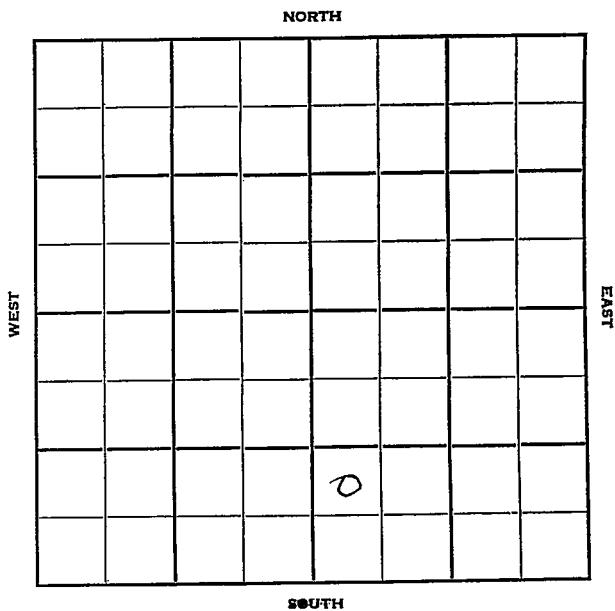

Sec. 17 Twp. 21 R. 13 W ✓

Well No. #2 Vink Farm

Cities Service Company

Holm Drlg. Contractor

Hazel Pool


Ft. from N. Line

990 Ft. from S. Line

Ft. from E. Line

330 Ft. from W. Line

NW SW SE

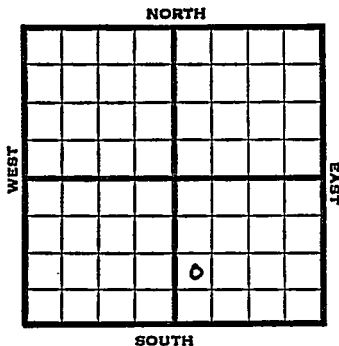

1951

Elev. 1903' REPORT

2/7

Spud 2/4/51
8" @355
WOC

2/21

Spd 2-4-51
D&A TD 3720
8" @ 355' Lans. 3357'
Cong. 3616' Viola 3619
Simp sh 3656 Simp Sd 3674
Arb. 3713
DST 3715-20 opn 1/2 hr
Rec. 170' wtr TD 3720
D&A

ABANDONED

County **Stafford** State **Kansas**

Sec. **17** (Blk. Twp.) **21** (Sur. Rge.) **13W** Map No.

Operator **Cities Service**

Well No. **2** Farm **Vink**

Elev. Location **NW SW SE**

FIRST REPORT					

990 Ft. From **S** Line **SE**

330 Ft. From **W** Line Quarter

1st. Report **FEB 7 1951**

Completion

Remarks

Holm Drlg. - Contr.

Spudding Date **2-4-51**

Drlg. Data **Hazel Pool**

8" @ 355 W⁰C

J. E. TYRA

