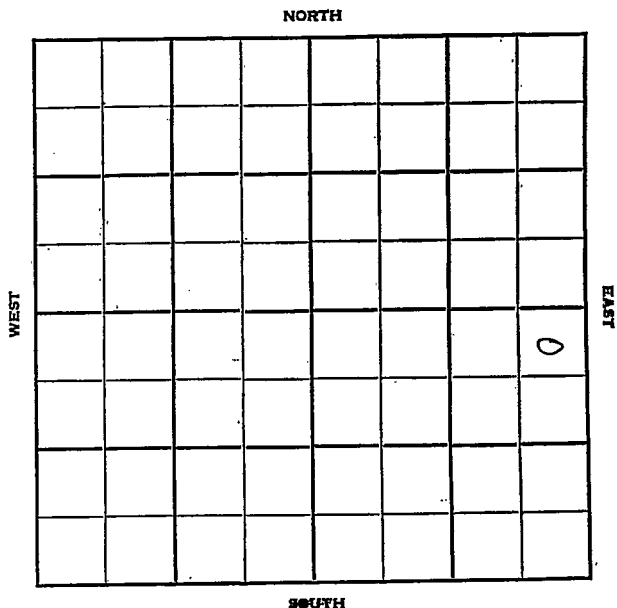


Section 17 Township 21 Range 13WWell No. #3 WaltersCompany C S O

Stafford

KANSAS

Sec. 17 Twp. 21 R. 13W

Well No. #3 Walters Farm

C. S.O. Company

Peak - Contr. Contractor


330' Ft. from N. Line

_____ Ft. from S. Line

330' Ft. from E. Line

_____ Ft. from W. Line

NE NE SE

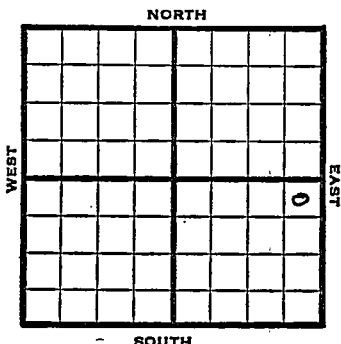

1952 Elev. 1899' REPORT

5/21 Spud 5-19-52
8" @ 350

5/28 NR

6/11 Spud 5-19-52
D&A TD 3805 8" @ 350
Br Li 3350 Lans. 3360
DST 3427-40 open 1 hr. rec. 60' mud
& wtr.
DST 3446-53 open 1 hr. rec. 90' mud
& wtr. Cong. 3616'
DST 3617-64 open $\frac{1}{2}$ hr. rec. 10' mud
Viola 3640 Simp. 3710
Arb. 3785 TD 3805 D&A

ABANDONED

County Stafford State Kansas
Sec. 17 (Blk. 21 (Sur. 135 Map No.
Twp.) Rge.)

Operator C. S. D.

Well No. **3** Farm **Walters**

Elev.	Location	NE	NW	SE
-------	----------	----	----	----

330 Ft. From N Line SE

330 Ft. From E Line Quarter

1st. Report **MAY 21 1952**

Completion _____

Remarks


Peak Contr.

Spudding Date **5-19-52**

Drlg. Data

8th @ 350

J. G. McGEHEE

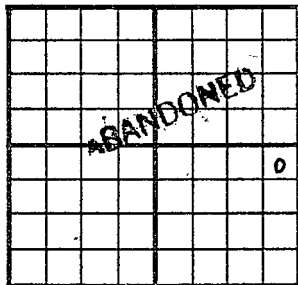County Stafford State KansasSec. 17 (Blk.
Twp.) 21 (Sur.
Rge.) 13W Map No.Operator Cities ServiceWell No. 3 Farm WaltersElev. 1899 Location NE NE SE330 Ft. From N Line SE330 Ft. From E Line Quarter1st. ReportCompletion JUN 11 1952RemarksPeel - Contr.Spudding Date 5-19-52Drlg. Data D & A TD 38058" @ 350 Br. lime 3350 Lans. 3360DST 3427-40 open 1 hr. Rec. 60' mud
& water DST 3446-53 open 1 hr.Rec. 90' mud & water Cong. 3616DST 3617-64 open $\frac{1}{2}$ hr. Rec. 10' mudViola 3640 Simp. 3710 Arb. 3785TD 3805D & A

J. G. McGEHEE