


Section **17** Township **21** Range **14W**Well No. **#1 Lincoln**Company **Harms & Knight**

NORTH

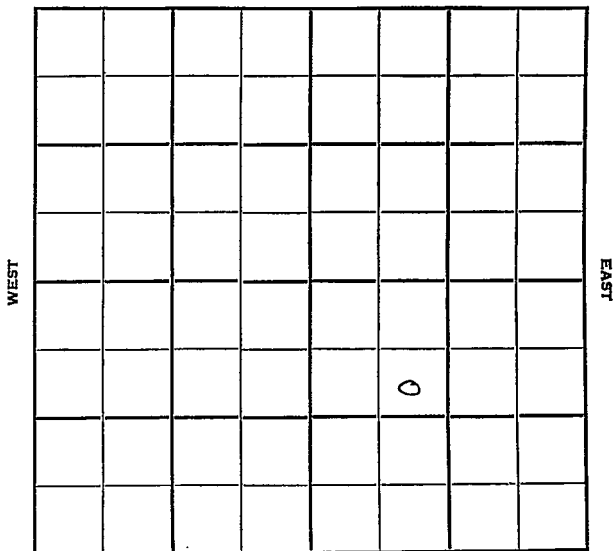

SOUTH

Stafford **KANSAS**

Sec. 17 Twp. 21 R. 14 W

Well No. # 1 Lincoln Farm

Harms & Knight Company

Wildcat Contractor


990 Ft. from N. Line

 Ft. from S. Line

 Ft. from E. Line

990 Ft. from W. Line

SE NW SE

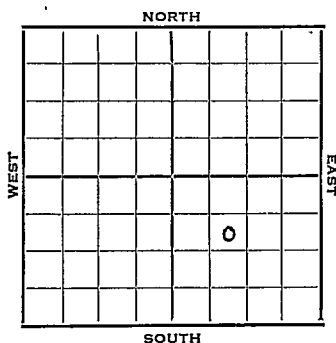


1951 Elev. 1940' REPORT

12/5 Spud 12-3-51
8" @ 265' WOC

12/19 Spud 12-3-51
D & A TD 3796' 8" @ 265
Heeb 3276'
Br. lime 3398'
KC 3409'
DST 3550-3625 open 25 min. rec 20'
mud.
Cong. 3655'
Viola 3660'
Simp. 3691'
Arb. 3746-96' TD
D & A

ABANDONED

County **Stafford** State **Kansas**
 Sec. **17** (Blk. Twp.) **21** (Sur. Rge.) **14W** Map No.
 Operator **Harms & Knight**
 Well No. **1** Farm **Lincoln**
 Elev. Location **SE NW SE**

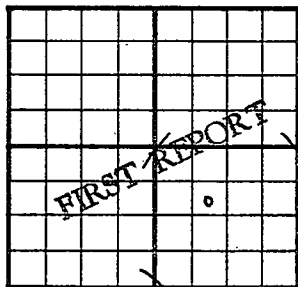

990 Ft. From **N** Line **SE**

990 Ft. From **W** Line Quarter

1st. Report **DEC 5 1951**

Completion

Remarks

Spudding Date **12-3-51**


Drlg. Data

Wildcat

8" @ 265 WOC

J. E. TYRA

County Stafford State Kansas
 Sec. 17 (Blk. Twp.) 21 (Sur. Rge.) 14W Map No.
 Operator Harms & Knight
 Well No. 1 Farm Lincoln
 Elev. 1940 Location SE NW SE

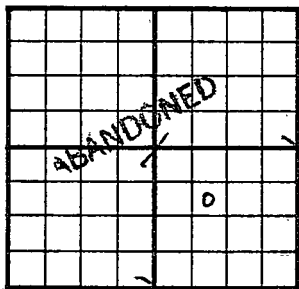

990 Ft. From N Line SE
 990 Ft. From W Line Quarter

1st. Report

Completion DEC 1 9 1951

Remarks Wildcat

Spudding Date 12-3-51

Drlg. Data D & A TD 3796

8" @ 265 Heeb. 3276 Br. lime 3398

KC 3409 DST 3550-3625 open 25 min.

Rec. 20' mud Cong. 3655 Viola 3660

Simp. 3691 Arb. 3746-96 TD

D & A

J. E. TYRA