

Section 17 Township 21 Range 14W

Well No. 1 Asher

Company M B Armer

Wildcat
NORTH

WEST

EAST

SOUTH

0

1

Stafford

Sec. 17 Twp. 21 R. 14W ☒

Well No. #1 Asher Farm

M. B. Armer Company

Wildcat


 Ft. from N. Line

330' Ft. from S. Line

 Ft. from E. Line

330' Ft. from W. Line

SW NW

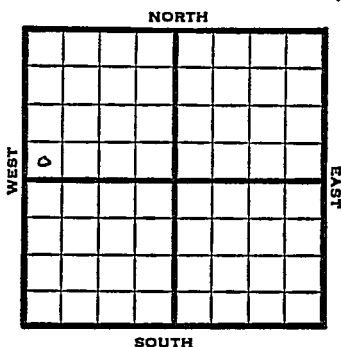

1949	lev 1939'	REPORT
1/12	Location	
1/19	"	
1/26	"	
2/2	"	
2/9	"	
2/16	"	
2/23	Surface Hook	
3/2	8" @ 887'	
	Drlg. 2219'	
3/8	Lansing 3381'	
	Viola 3645'	
	Drlg 3677'	
3/16	TD 3775'	
	Simp 3674	
	Arb. 3723'	
	Aband.	
	ABANDONED	

Kansas


Map No. _____ Sec. 17 Twp. 21 R. 14WWell No. 1 AsherM. B. Armer Company

FIRST REPORT

Contractor

SW NW

SECTION PLAT

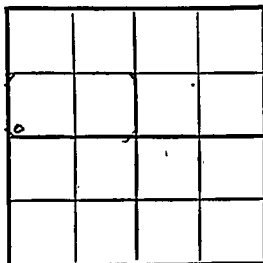 Ft. from N. Line330 Ft. from S. Line Ft. from E. Line330 Ft. from W. Line

Stafford County

RECORD

Location XCased in., ft.Rig up Sand Drilling and Remarks: Gas Oil Total Depth

PRODUCTION

1st 24 hrs. Nat. 1st 24 hrs. after shot Gas Cu. Ft.Dry Hole Abandoned

Date

JAN 12 1929 19

S. J. LEWIS

Scout

Kansas

Map No. 82 Sec. 17 Twp. 21 R. 14WWell No. 1 AsherM. B. Armer

Company

ABANDONED

Contractor

SW NW

E. H. 1929
SECTION PLAT

0			

Ft. from N. Line

330

Ft. from S. Line

Ft. from E. Line

330

Ft. from W. Line

Stafford County

Location

Rig up

Drilling and Remarks:

Drilling 3674
Per 49723

RECORD

Cased _____ in., _____ ft.

Sand _____

Gas _____

Oil _____

Total Depth 69725

PRODUCTION

1st 24 hrs. Nat. _____

1st 24 hrs. after shot _____

Gas _____ Cu. Ft.

Dry Hole _____

Abandoned _____

Date

MAR 16 1949 19

S. I. LEWIS Scout