

Section 17 Township 21 Range 15W

Well No. #1 Schmitt

Company Pabco Drlg. et al

NORTH

WEST

EAST

							0

SOUTH

Pawnee

Sec. 17 Twp. 21 R. KANSAS 15 W ☒

Well No. # 1 Schmitt Farm

Pabco Drlg. et al Company

Wildcat Contractor


330 Ft. from N. Line

 Ft. from S. Line

330 Ft. from E. Line

 Ft. from W. Line

NE NE SE

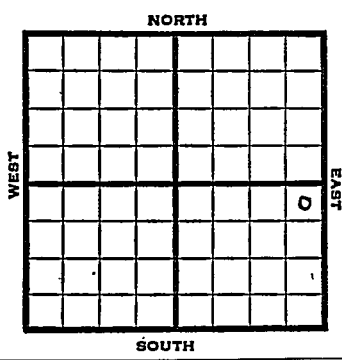

1951

Elev. 1954' REPORT


9/5

8" @ 878'
Drlg. 1825'

9/19

Spud 8-31-51
8" @ 878
Heeb. 3343 Lans. 3445
Cong. 3763 Arb. 3822-50 TD
D&A

ABANDONED

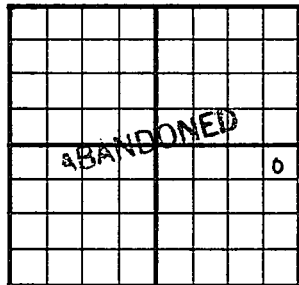County Pawnee State KansasSec. 17 (Blk.
Twp.) 21 (Sur.
Rge.) 15W Map No.Operator Pabco Drlg. etal.Well No. 1 Farm SchmittElev. 1954 Location NE NE SE330 Ft. From N Line SE330 Ft. From E Line QuarterIst. ReportCompletion SEP 19 1951Remarks WildcatSpudding Date 8-31-51Drlg. Data D & A TD 38508" @ 878 Heeb. 3343 Lans. 3445Cong. 3763 Arb. 3822-50 TDD & A

J. E. TYRA