

Pawnee


DX 78-1

KANSAS

Section 17 Township 21 Range 15W

Well No. #1 Schmitt "A"

Company Musgrove Pet.

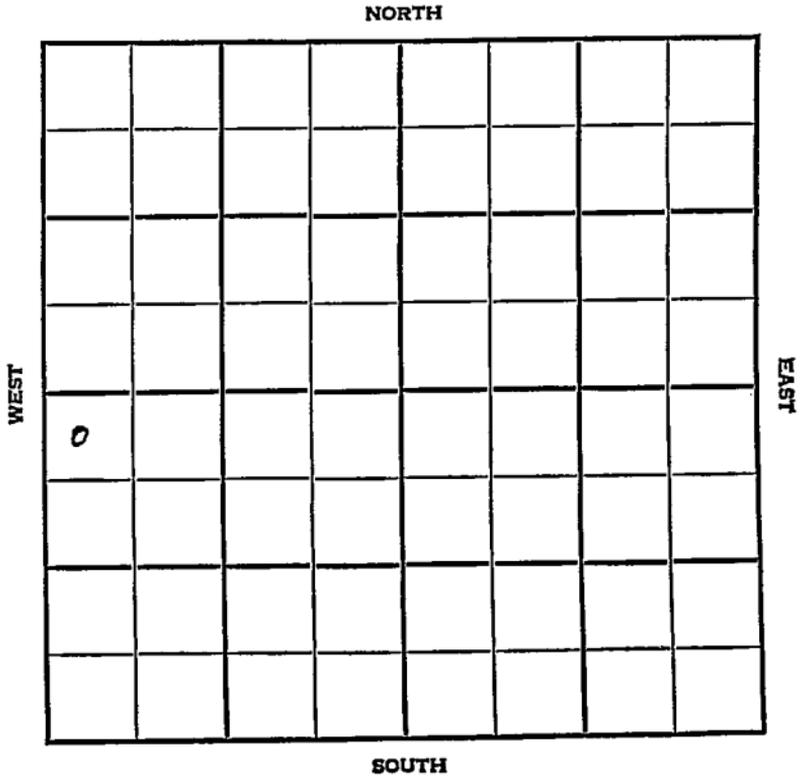

Pawnee

KANSAS

SEC. 17	TWP. 21	R. 15W
------------	------------	-----------


WELL NO. #1 Schmitt "A" FARM

COMPANY Musgrove Petroleum

CONTRACTOR Co. Tools.

Semi-WC Pool_{LTH}

330 Ft. from N. Line
 Ft. from S. Line
 Ft. from E. Line
 330 Ft. from W. Line

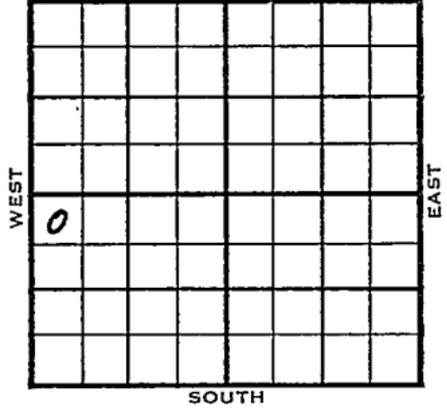

NW NW SW

1954	ELEVATION 1961'	REPORT
------	--------------------	--------

9/22 Spud 9-18-54
 8" @ 951'
 Drlg. 1465'

12/15 Spud 9-18-54 Oil well TD 3883'
 8" @ 951 Heeb 3322 Tor. 3343
 Doug 3355 Br. lime 3426 Lans 3435
 DST 3437-55 open 1 hr rec 30' mud 0#
 B KC 3660 Cong 3724 Chert 3734'
 Simp. 3785 Arb. 3812 TD 3883
 5" @ 3882 CO to 3873 32/3840-44
 S/2 1/2 BOPH 4 hr. 100,000 CFG 300 A
 F/5 BOPH 6 hr. 1,250,000 CFG
 Comp. F/7.2 BOPD 950,000 CFG

COMPLETED

